

MISSISSIPPI DEPARTMENT OF NATURAL RESOURCES

Bureau of Land and Water Resources

Southport Mall

P.O. Box 10631

Jackson, Mississippi 39209

WATER WELL DRILLERS LOG

Tunica
Gravel

3-29-19 84 Delta Well & Drig Tunica
date well completed firm name county well located

LANDOWNER:
William Houston
Tunica Miss.
(mailing address)


description of formations encountered	from	to
<u>CLAY</u>	<u>0</u>	<u>45</u>
<u>FINE SAND</u>	<u>45</u>	<u>60</u>
<u>SAND & ROCKS</u>	<u>60</u>	<u>110</u>

WELL LOCATION:
sec. 26 T 5 N R. 11 E
4 miles NE of Tunica
(distance) (direction) (nearest town)

WELL PURPOSE: irrigation
(home, irrigation, municipal, industrial)

- WELL COMPLETION DATA:
- (1) diameter (inches) 8"
 - (2) total depth (feet) 110'
 - (3) static water level (feet) 15 below above top of ground.
 - (4) casing PVC, 110'
(material) (depth)
8" If telescope see back.
(size)
 - (5) screen 40', 70'
(length) (depth to top)
8", PVC
(size) (material)
 - (6) pump 10, 750
(HP) (yield gpm)
220 volt
(type power)
 - (7) electric log no
(yes or no)

(organization running log)
 - (8) how well bottom plugged PVC
cap

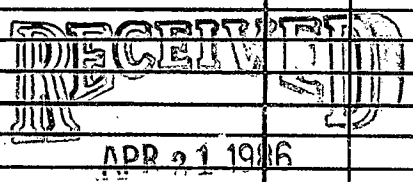


Department of Natural Resources
Bureau of Land & Water Resources

DRILLERS REMARKS:

If well telescopes please sketch and show depths.

GROUND LEVEL

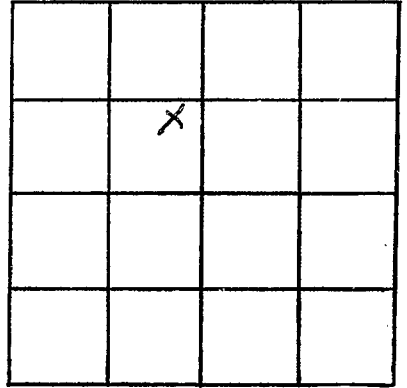

SECTION 26

Please indicate well location X.

ADDITIONAL INFORMATION

If more than one screen,
show locations of each on sketch.