

**MISSISSIPPI DEPARTMENT OF NATURAL RESOURCES**  
**Bureau of Land and Water Resources**  
 Southport Mall  
 P.O. Box 10631  
 Jackson, Mississippi 39209  
**WATER WELL DRILLERS LOG**

TUNICA  
Gravel

4-14 1984 Delta Well & Irrig TUNICA  
 date well completed firm name county well located


LANDOWNER:	description of formations encountered	from	to
<u>ABBY'S LEATHERMAN</u> <u>Tunica Miss</u> (mailing address)			
<b>WELL LOCATION:</b> sec. <u>31</u> T. <u>E</u> N. R. <u>11</u> E <u>1 1/4</u> miles <u>W</u> of <u>TUNICA</u> (distance) (direction) (nearest town)	<u>FINE SAND</u>	<u>40</u>	<u>55</u>
<b>WELL PURPOSE:</b> (home, irrigation, municipal, industrial)	<u>SAND &amp; ROCKS</u>	<u>55</u>	<u>103</u>
<b>WELL COMPLETION DATA:</b>			
(1) diameter (inches) <u>12"</u>			
(2) total depth (feet) <u>103'</u>			
(3) static water level (feet) <u>12</u> <u>below</u> top of ground.			
(4) casing <u>STEEL</u> , <u>103'</u> (material) (depth) <u>12"</u> If telescope see back. (size)			
(5) screen <u>40'</u> , <u>63'</u> (length) (depth to top) <u>12"</u> , <u>STEEL</u> (size) (material)			
(6) pump <u>20</u> <u>1500</u> (HP) (yield gpm) <u>ELC</u> (type power)			
(7) electric log <u>no</u> (yes or no)  (organization running log)			
(8) how well bottom plugged <u>STEEL</u> <u>CAP</u>			
<b>DRILLERS REMARKS:</b>			

**RECEIVED**  
 APR 27 1986

Department of Natural Resources  
 Bureau of Land & Water Resources

If well telescopes please sketch and show depths.

GROUND LEVEL

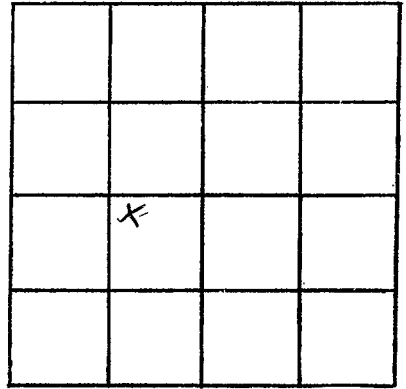

SECTION 31

Please indicate well location X.

ADDITIONAL INFORMATION

If more than one screen,  
show locations of each on sketch.