

12696  
 CODED 1/69  
 CODED  
 22952

MISSISSIPPI  
 BOARD OF WATER COMMISSIONERS  
 416 North State Street  
 Jackson, Mississippi 39201  
 WATER WELL DRILLERS LOG

Tunica  
 H 3.  
 7-13-69

July 13, 19 69 Layne-Central Company Tunica  
 date well completed firm name county well located

LANDOWNER: Paul Battle  
 Route 2, Tunica, Mississippi  
 (mailing address)

description of formations encountered	from	to
Clay	0	50
Coarse sand, pea gravel	50	80
Coarse sand, gravel	80	112

WELL LOCATION:  
 sec. 30 T 5 N R 10 E  
 S W  
 6 miles SE of Tunica  
 (distance) (direction) (nearest town)

WELL PURPOSE: irrigation  
 (home, irrigation, municipal, industrial)

- WELL COMPLETION DATA:
- (1) diameter (inches) 12
  - (2) total depth (feet) 112
  - (3) static water level (feet) 22' 6" below top of ground.
  - (4) casing steel, 72' (material), (depth), 12" (size) if telescope see back.
  - (5) screen 40' (length), 112' (depth to top), 12" (size), Armco (material)
  - (6) pump 40 (HP), 1500 (yield gpm), engine (type power)
  - (7) electric log no (yes or no)  
 (organization running log)
  - (8) how well bottom plugged plate


CODED

DRILLERS REMARKS:

MISS. DEPT. OF REVENUE  
 19 10 1969

If well telescopes please sketch and show depths.

GROUND LEVEL

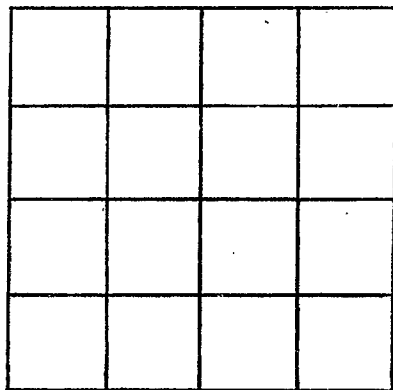

SECTION 30

Please indicate well location X.

ADDITIONAL INFORMATION

If more than one screen,  
show locations of each on sketch.