

CODED

MISSISSIPPI  
BOARD OF WATER COMMISSIONERS  
416 North State Street  
Jackson, Mississippi 39201

CODED

WATER WELL DRILLERS LOG

Junica  
74  
11-28-69

Nov 28 19 69 Shelby Neyman Junica  
date well completed firm name county well located

LANDOWNER: Mrs J J Powell  
P.O. Box 46  
Junica Miss.  
(mailing address)

description of formations encountered	from	to
<u>Dark Clay</u>	<u>0</u>	<u>40</u>
<u>grey Coarse Sand</u>	<u>40</u>	<u>50</u>

WELL LOCATION:  
sec. 22 T. 5 N. R. 10 E.  
S. W.  
1 miles W of Savage  
(distance) (direction) (nearest town)

WELL PURPOSE: Home  
(home, irrigation, municipal, industrial)

- WELL COMPLETION DATA:
- (1) diameter (inches) 2
  - (2) total depth (feet) 50
  - (3) static water level (feet) 14 below top of ground.
  - (4) casing Galvanize (material) (depth) \_\_\_\_\_  
(size) if telescope see back.
  - (5) screen 5 ft (length) (depth to top) \_\_\_\_\_  
1 1/4 (size) Stainless Steel (material)
  - (6) pump 1/2 (HP) 12 (yield gpm)  
Electric (type power)
  - (7) electric log no (yes or no)  
no (organization running log)
  - (8) how well bottom plugged Rubber seal

CODED


DEC 16 1969

MISS. BUL. OF  
WATER COMMISSIONERS

DRILLERS REMARKS:

If well telescopes please sketch and show depths.

GROUND LEVEL

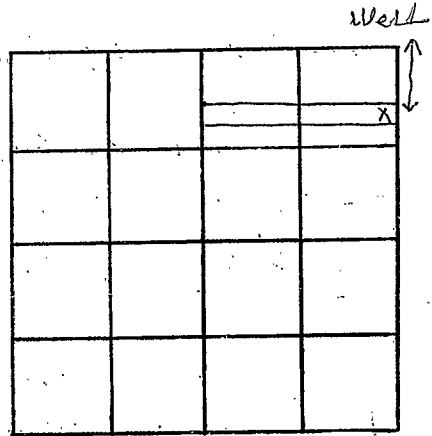

SECTION 2/3

Please indicate well location X.

ADDITIONAL INFORMATION

If more than one screen, show locations of each on sketch.