

CODED

MISSISSIPPI  
BOARD OF WATER COMMISSIONERS  
416 North State Street  
Jackson, Mississippi 39201

WATER WELL DRILLERS LOG

DYER WELL & IRRIGATION SERVICE

TUNICA

TUNICA  
# 5  
1-13-70

1-13-70  
date well completed

19

firm name

county well located

LANDOWNER:

PAUL BATTLE, JR.

TUNICA, MISS.  
(mailing address)

description of formations encountered

from

to

CLAY	0	33
FINE SAND	33	53
COARSE BROWN SAND	53	63
SAND + GRAVEL	63	103

WELL LOCATION:

sec. 3 T. 5 N. R. 10 E.  
S W  
2 miles S of Little Tena  
(distance) (direction) (nearest town)

WELL PURPOSE: IRR.  
(home, irrigation, municipal, industrial)

WELL COMPLETION DATA:

- (1) diameter (inches) 16"
- (2) total depth (feet) 103
- (3) static water level (feet) 19 below above top of ground.
- (4) casing Steel, 63  
(material) (depth)  
16" if telescope see back.  
(size)
- (5) screen 40, 63  
(length) (depth to top)  
16", Steel  
(size) (material)
- (6) pump 60 3000  
(HP) (yield gpm)  
Diesel  
(type power)
- (7) electric log no  
(yes or no)

(organization running log)

(8) how well bottom plugged Plate


DRILLERS REMARKS:

Jeh.  
2 - 1970

MISS. BD. OF  
WATER COMM.

If well telescopes please sketch and show depths.

GROUND LEVEL

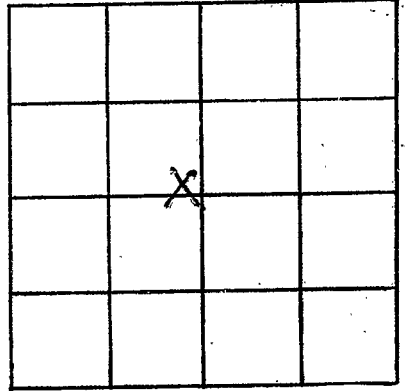

SECTION 32

Please indicate well location X.

ADDITIONAL INFORMATION

If more than one screen, show locations of each on sketch.