

Tunica  
H 6  
3-2-70

MISSISSIPPI  
BOARD OF WATER COMMISSIONERS  
416 North State Street  
Jackson, Mississippi 39201

RTA 3/13/70  
Recd  
MARCH 19 1970

WATER WELL DRILLERS LOG

3/2 1970 J. H. ABEL & SON, INC. Tunica  
date well completed firm name county well located

LANDOWNER: MR. PAUL BATTLE  
Tunica, Mississippi  
38676 (mailing address)

description of formations encountered	from	to
CLAY	1'	20'
FINE POWDER SAND	20'	30'
FINE SAND	30'	50'
MED SAND	50'	60'
COARSE SAND + SMALL GRAVEL	60'	75'

WELL LOCATION:  
sec 27 T 5 S R 10 W  
Approx 6 miles SW of Tunica  
(distance) (direction) (nearest town)

WELL PURPOSE: FISH PONDS  
(home, irrigation, municipal, industrial)

WELL COMPLETION DATA:  
(1) diameter (inches) 4" ID  
(2) total depth (feet) 75  
(3) static water level (feet) 13 below top of ground.  
(4) casing 4" GALV. (material), 65' (depth)  
if telescope see back.  
(5) screen 10' (length), 65' (depth to top)  
4" ID, WESCO SS (size) (material)  
(6) pump 3 (HP), 1400 (yield gpm)  
ELECTRIC MOTOR (type power)  
(7) electric log NO (yes or no)  
(organization running log)  
(8) how well bottom plugged STEEL

COPIED

MAR 19 1970

MISS. BD. OF  
WATER COMM.

DRILLERS REMARKS: WELL  
AGGERED IN - USED FOR  
FISH POND AT WACTONIA


If well telescopes please sketch and show depths.

GROUND LEVEL

STRAIGHT 4"

WELL

DR. GEARED IN.

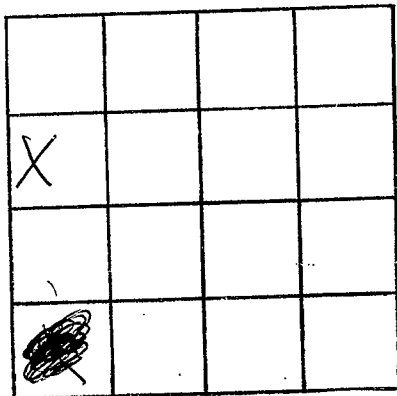

SECTION 27

Please indicate well location X.

ADDITIONAL INFORMATION

WELL MAT

65' 4" GALV. T+C

STD. PIPE

10' 4" WESCO 10 SLOT

UNDER WELL SCREEN

HAS 3 1/2" IPH 220V.

SELF PRIMING CMT.

PUMP CONNECTED TO TOP OF WELL

PUMPS ARE NOT 140-

160-GAM

If more than one screen, show locations of each on sketch.