

TUNICA
H 7
8-1-70

MISSISSIPPI
BOARD OF WATER COMMISSIONERS
416 North State Street
Jackson, Mississippi 39201

CODED

WATER WELL DRILLERS LOG

Aug 1 1970 Shelby Neyman Tunica
date well completed firm name county well located

LANDOWNER: W.C. McLean
Tunica
Miss
(mailing address)

description of formations encountered	from	to
<u>Dark Clay</u>	<u>0</u>	<u>20</u>
<u>white clay</u>	<u>20</u>	<u>60</u>
<u>grey sand</u>	<u>60</u>	<u>81</u>

WELL LOCATION:
sec. 29 T 5 N R 10 E
10 miles SE of Tunica
(distance) (direction) (nearest town)

WELL PURPOSE: gamma water
(home, irrigation, municipal, industrial)

- WELL COMPLETION DATA:
- (1) diameter (inches) 2
 - (2) total depth (feet) 81
 - (3) static water level (feet) 16 below top of ground.
 - (4) casing Galvanz (material), (depth)
(size) if telescope see back.
 - (5) screen 5 (length), (depth to top)
1 1/2 (size), ST, ST (material)
 - (6) pump Pitcher (HP), (yield gpm)
Pytlard (type power)
 - (7) electric log no (yes or no)
no (organization running log)
 - (8) how well bottom plugged Rubber Seal


CODED

DRILLERS REMARKS:

SEP 14 1970

If well telescopes please sketch and show depths.

GROUND LEVEL

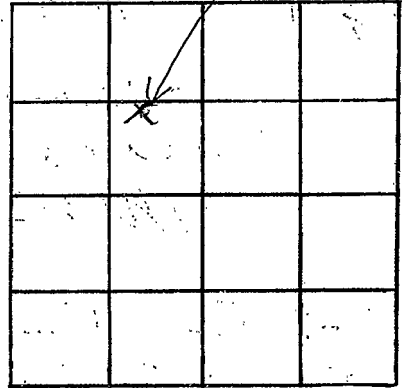

S
SECTION 29

Please indicate well location X.

ADDITIONAL INFORMATION

If more than one screen, show locations of each on sketch.