


CODED

MISSISSIPPI
BOARD OF WATER COMMISSIONERS
416 North State Street
Jackson, Mississippi 39201

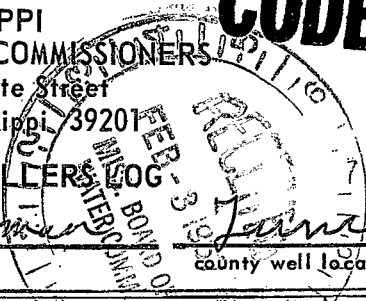

WATER WELL DRILLERS LOG

Tunica
H 10
1-67

Jan 16 1967 date well completed
Shelby Newman firm name
Tunica county well located

LANDOWNER: H. G. Dudley
Route 1, Box 173
Tunica
(mailing address)

description of formations encountered	from	to
Blue Clay	0	20
Blue Clay & Sand	20	50
Blue Sand	50	82

WELL LOCATION:
sec. 5 T. 5 S. R. 10 W. E. 1
5 1/2 miles E of Tunica
(distance) (direction) (nearest town)

WELL PURPOSE: Home
(home, irrigation, municipal, industrial)

WELL COMPLETION DATA:


- (1) diameter (inches) 2
- (2) total depth (feet) 72
- (3) static water level (feet) 14 below top of ground.
- (4) casing Metal 63
(material) (depth)
- 2 If telescope see back.
(size)
- (5) screen 5 ft 63
(length) (depth to top)
- 1 1/4 Stamper Steel
(size) (material)
- (6) pump 1 16
(HP) (yield gpm)
- Electric
(type power)
- (7) electric log no
(yes or no)
- no
(organization running log)
- (8) how well bottom plugged Rubber Seal

CODED

DRILLERS REMARKS:

If well telescopes please sketch and show depths.

GROUND LEVEL

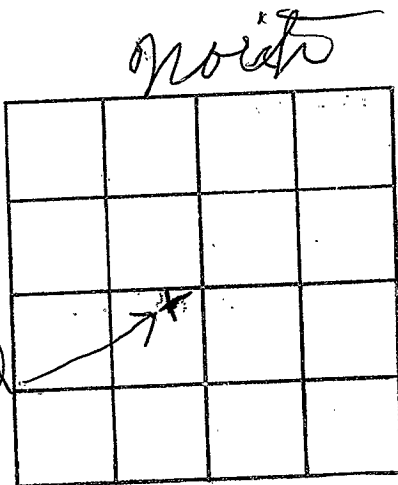

SECTION _____

Please indicate well location X.

ADDITIONAL INFORMATION

If more than one screen, show locations of each on sketch.