

TUNICA
H 13
9-1-79

MISSISSIPPI
BOARD OF WATER COMMISSIONERS
416 North State Street
Jackson, Mississippi 39201 **CODED**

WATER WELL DRILLERS LOG

9-1 date well completed 1974 Hester Dullough Tunica firm name county well located


LANDOWNER: Paul Battle	description of formations encountered	from	to
Tunica Miss.			
(mailing address)	Blue clay	0	35
	fine sand	35	75
	Coarse sand	75	118

WELL LOCATION:
sec. 30 T. 5 S. R. 10 E.
1 miles S of Little Jaxas
(distance) (direction) (nearest town)

WELL PURPOSE: Fish
(home, irrigation, municipal, industrial)


- WELL COMPLETION DATA:
- (1) diameter (inches) 16"
 - (2) total depth (feet) 118
 - (3) static water level (feet) 21 below top of ground.
 - (4) casing steel, 78' (material) (depth)
16" if telescope see back. (size)
 - (5) screen 40' 78' (length) (depth to top)
16" steel (size) (material)
 - (6) pump 60 3000 (HP) (yield gpm)
Diesel (type power)
 - (7) electric log NO (yes or no)
 - (organization running log)
 - (8) how well bottom plugged Plate

DRILLERS REMARKS:

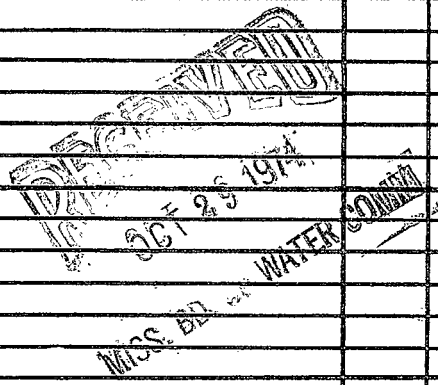

If well telescopes please sketch and show depths.

GROUND LEVEL

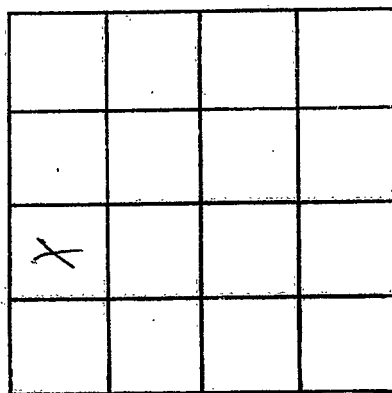

SECTION _____

Please indicate well location X.

ADDITIONAL INFORMATION

If more than one screen,
show locations of each on sketch.