

TUNICA
H 15
4-3-75

MISSISSIPPI
BOARD OF WATER COMMISSIONERS CODED
416 North State Street
Jackson, Mississippi 39201

WATER WELL DRILLERS LOG

4-3-75 date well completed
HESTER Drilling & TUNICA firm name
TUNICA county well located


LANDOWNER: <u>W.C. McLEAN</u>	description of formations encountered	from	to
<u>TUNICA MISS</u> (mailing address)			
	CLAY CLAY	0	18
	FINE SAND	18	45
	UPPER SAND & GRAVEL	45	103

WELL LOCATION:
sec. 29 T. 5 S. R. 10 W.
2 miles East of Little Texas
(distance) (direction) (nearest town)

WELL PURPOSE: LUBRICATION
(home, irrigation, municipal, industrial)


- WELL COMPLETION DATA:
- (1) diameter (inches) 16"
 - (2) total depth (feet) 103
 - (3) static water level (feet) 8 below/above top of ground.
 - (4) casing STEEL, 63 (material) (depth)
16' (size) if telescope see back.
 - (5) screen 40', 63' (length) (depth to top)
16", STEEL (size) (material)
 - (6) pump 50, 2200 (HP) (yield gpm)
DIPRO (type power)
 - (7) electric log NO (yes or no)
 - (8) how well bottom plugged PLATEM

DRILLERS REMARKS:

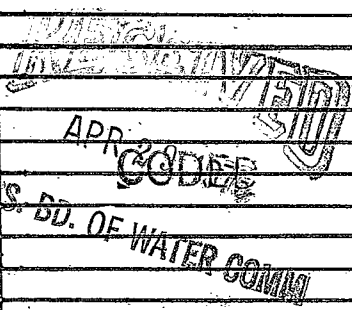

If well telescopes please sketch and show depths.

GROUND LEVEL

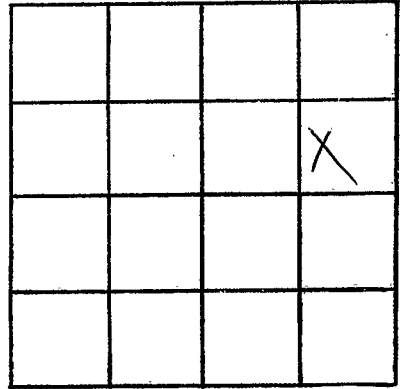

SECTION 29

Please indicate well location X.

ADDITIONAL INFORMATION

If more than one screen,
show locations of each on sketch.