

TUNICA
H/16
3-28-75

MISSISSIPPI
 BOARD OF WATER COMMISSIONERS
 416 North State Street
 Jackson, Mississippi 39201

CODED

WATER WELL DRILLERS LOG

3-28-75 19 Hester Drilling Tunica
 date well completed firm name county well located

LANDOWNER: <u>Paul Battle</u> <u>Tunica, Miss.</u>	description of formations encountered	from	to
(mailing address)	<u>clay</u>	<u>0</u>	<u>40</u>
WELL LOCATION: sec. <u>24</u> T. <u>S</u> R. <u>10</u> W	<u>fine sand</u>	<u>40</u>	<u>55</u>
<u>1</u> miles <u>N</u> of <u>Little Texas</u> (distance) (direction) (nearest town)	<u>coarse sand & gravel</u>	<u>55</u>	<u>100</u>
WELL PURPOSE: <u>Domestic</u> (home, irrigation, municipal, industrial)			
WELL COMPLETION DATA:			
(1) diameter (inches) <u>12</u>			
(2) total depth (feet) <u>6</u> <u>100</u>			
(3) static water level (feet) <u>10</u> below/above top of ground.			
(4) casing <u>steel</u> , <u>60</u> (material) (depth)			
<u>12</u> if telescope see back. (size)			
(5) screen <u>140'</u> , <u>60'</u> (length) (depth to top)			
<u>12"</u> , <u>steel</u> (size) (material)			
(6) pump <u>30</u> <u>2000</u> (HP) (yield gpm)			
<u>Electric</u> (type power)			
(7) electric log <u>no</u> (yes or no)			
(organization running log)			
(8) how well bottom plugged <u>plate</u>			
DRILLERS REMARKS:			

CODED


RECEIVED

APR 29 1975

MISS. BD. OF WATER COMMISSIONERS

If well telescopes please sketch and show depths.

GROUND LEVEL

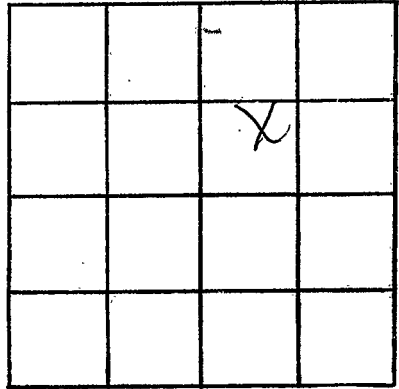

SECTION 24

Please indicate well location X.

ADDITIONAL INFORMATION

If more than one screen, show locations of each on sketch.