

TUNICA  
H17  
9-16-77

MISSISSIPPI  
BOARD OF WATER COMMISSIONERS  
416 North State Street  
Jackson, Mississippi 39201

WATER WELL DRILLERS LOG

CODED

9-16 1977 Hester Drilling Co TUNICA  
date well completed firm name county well located

LANDOWNER: M. Montgomery  
~~Fernier Mrs~~  
MEXICO  
(mailing address)

description of formations encountered	from	to
CLAY	0	40
pink sand	40	55
course sand gravel	55	103

WELL LOCATION:  
sec. 9 T. 55 R. 10 E  
miles of  
(distance) (direction) (nearest town)

WELL PURPOSE: irrigation  
(home, irrigation, municipal, industrial)

CODED

- WELL COMPLETION DATA:
- (1) diameter (inches) 16"
  - (2) total depth (feet) 103
  - (3) static water level (feet) 12 below top of ground.
  - (4) casing 16" 103  
(material) (depth)
  - 16" if telescope see back.  
(size)
  - (5) screen 40' 103'  
(length) (depth to top)
  - 16" STEEL  
(size) (material)
  - (6) pump 60 3000  
(HP) (yield gpm)
  - DIKSKI  
(type power)
  - (7) electric log NO  
(yes or no)


(organization running log) Plot  
(8) how well bottom plugged

DRILLERS REMARKS:

RECEIVED  
NOV 20 1977  
MISS. BD. OF WATER COMM

If well telescopes please sketch and show depths.

GROUND LEVEL

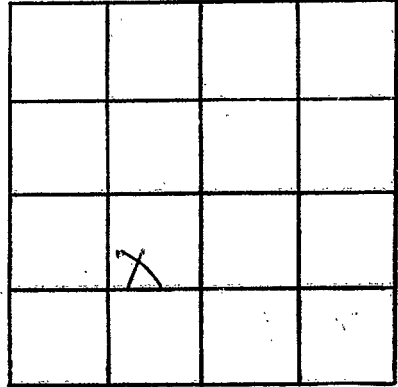

SECTION 9

Please indicate well location X.

ADDITIONAL INFORMATION

Lined area for additional information.

If more than one screen, show locations of each on sketch.