

TUNICA
H 18
9-10-77

MISSISSIPPI
BOARD OF WATER COMMISSIONERS
416 North State Street
Jackson, Mississippi 39201

CODED

WATER WELL DRILLERS LOG

9-10 date well completed
1977 Hester Drilling Co. firm name
Tunica county well located

LANDOWNER:	description of formations encountered	from	to
W. H. Houston	clay	0	28
Tunica Miss	fine sand	28	56
(mailing address)	pears sand (gravel)	56	110

WELL LOCATION:
sec. 7 T. 5 N. R. 10 E.
(distance) miles of (direction) (nearest town)

CODED

WELL PURPOSE: irrigation
(home, irrigation, municipal, industrial)

- WELL COMPLETION DATA:
- (1) diameter (inches) 16"
 - (2) total depth (feet) 110
 - (3) static water level (feet) 14 ^X below above top of ground.
 - (4) casing steel 16' 16"
(material) (depth) (size) If telescope see back.
 - (5) screen 40' 16" steel
(length) (depth to top) (size) (material)
 - (6) pump 100 3000
(HP) (yield gpm)
Electric
(type power)
 - (7) electric log NO
(yes or no)

(organization running log)
(8) how well bottom plugged Plate


DRILLERS REMARKS:

RECEIVED
NOV 10 1977

MISS. BD. OF WATER COMMISSIONERS

If well telescopes please sketch and show depths.

GROUND LEVEL

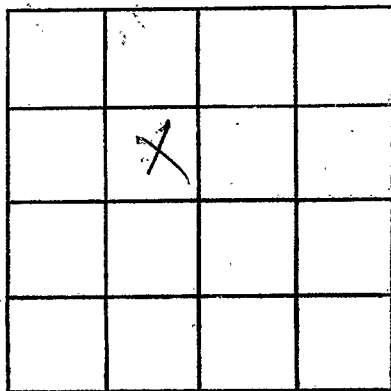

SECTION 7

Please indicate well location X.

ADDITIONAL INFORMATION

If more than one screen,
show locations of each on sketch.