

TUNICA  
H2O  
8-21-78

MISSISSIPPI  
BOARD OF WATER COMMISSIONERS  
416 North State Street  
Jackson, Mississippi 39201

CODED

WATER WELL DRILLERS LOG

8-21 1978 Western Drilling Co Tunica  
date well completed firm name county well located

LANDOWNER:	description of formations encountered	from	to
<u>Jim Power Sr</u> <u>Tunica Miss</u>	<u>clay</u>	<u>0</u>	<u>40</u>
(mailing address)	<u>lime sand</u>	<u>40</u>	<u>58</u>
	<u>EDGERS SAND &amp; GRAVEL</u>	<u>50</u>	<u>103</u>

WELL LOCATION:  
sec 15 T 5 N R 10 E  
4 1/2 miles E of TUNICA  
(distance) (direction) (nearest town)

WELL PURPOSE:  
(home, irrigation, municipal, industrial)

CODED

- WELL COMPLETION DATA:
- (1) diameter (inches) 12"
  - (2) total depth (feet) 103
  - (3) static water level (feet) 12 <sup>below</sup> <sub>above</sub> top of ground.
  - (4) casing steel, 63'  
(material) (depth)  
12"  
(size) If telescope see back.
  - (5) screen 40', 63'  
(length) (depth to top)  
12, steel  
(size) (material)
  - (6) pump 30 2000  
(HP) (yield gpm)  
DIESEL  
(type power)
  - (7) electric log no  
(yes or no)
- (organization running log)
- (8) how well bottom plugged Plastic


RECEIVED  
SEP 18 1978

DRILLERS REMARKS:

MISS. BD. OF WATER COMM

If well telescopes please sketch and show depths.

GROUND LEVEL

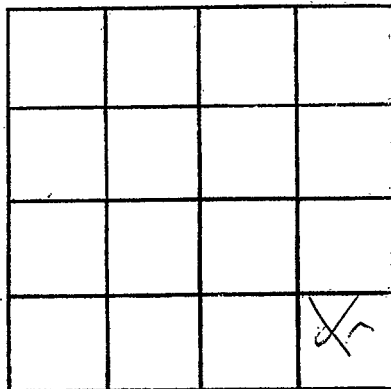

SECTION \_\_\_\_\_

Please indicate well location X.

ADDITIONAL INFORMATION

If more than one screen, show locations of each on sketch.