

TUNICA
H 21
4-17-80

MISSISSIPPI
BOARD OF WATER COMMISSIONERS
416 North State Street
Jackson, Mississippi 39201

CODED

WATER WELL DRILLERS LOG

4-17-80
date well completed

Hester Drilling Co
firm name

Tunica
county well located

LANDOWNER: Jim Power, J.R.
Tunica MS

description of formations encountered	from	to
clay	0	48
fine sand	48	60
coarse sand & gravel	60	108

(mailing address)

WELL LOCATION:
sec 17 T 6 N R 10 E
6 miles E of Tunica
(distance) (direction) (nearest town)

CODED

WELL PURPOSE: Irrigation
(home, irrigation, municipal, industrial)

- WELL COMPLETION DATA:
- (1) diameter (inches) 16"
 - (2) total depth (feet) 108
 - (3) static water level (feet) 12 below top of ground
 - (4) casing steel 68 (material) (depth)
16 (size) if telescope see back.
 - (5) screen 40' 68 (length) (depth to top)
16 (size) steel (material)
 - (6) pump 50 3000 (HP) (yield gpm)
Electric (type power)
 - (7) electric log NO (yes or no)

(organization running log)

(8) how well bottom plugged Pltk

DRILLERS REMARKS:


DEPT. OF NATURAL RESOURCES
BUREAU OF LAND & WATER RESOURCES

MAY 28 1980

RECEIVED

If well telescopes please sketch and show depths.

GROUND LEVEL

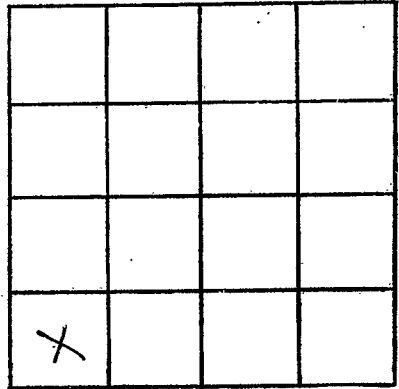

SECTION 17

Please indicate well location X.

ADDITIONAL INFORMATION

If more than one screen,
show locations of each on sketch.