

TUNICA  
H22  
4-16-81  
Elog # 15

MISSISSIPPI  
BOARD OF WATER COMMISSIONERS  
416 North State Street  
Jackson, Mississippi 39201

CODED

WATER WELL DRILLERS LOG

4-18-81 19 LIPWELL + SUPPLY TUNICA  
date well completed firm name county well located

LANDOWNER:  
PAUL BATTLE  
TUNICA MISS  
(mailing address)

description of formations encountered	from	to
TOP SOIL + CLAY	0	25
SAND	25	190
CLAY	190	285
SAND	285	336
CLAY	336	430
SAND	430	442
SAND + CLAY	442	1010
CLAY	1010	1510
SAND	1510	1685

WELL LOCATION:  
sec 30 T S N. R 10 E  
⑤ ⑥  
6 MI miles S of TUNICA  
(distance) (direction) (nearest town)

WELL PURPOSE:  
(home, irrigation, municipal, industrial)

WELL COMPLETION DATA:

(1) diameter (inches) 6 X 3

(2) total depth (feet) 1684

(3) static water level (feet) 18 below top of ground.

(4) casing STEEL, 1473,  
(material) (depth)  
6 X 3 if telescope see back.  
(size)

(5) screen 48' (length) (depth to top)  
SS  
(size) (material)

(6) pump 7 1/2 165  
(HP) (yield gpm)

ELEC.  
(type power)

(7) electric log yes  
(yes or no)  
MISS G S  
(organization running log)

(8) how well bottom plugged VALUE

CODED

1684  
48  
1636

DEPT. OF NATURAL RESOURCES  
BUREAU OF LAND & WATER RESOURCES



MAY 18 1981

RECEIVED

DRILLERS REMARKS:

If well telescopes please sketch and show depths.

GROUND LEVEL

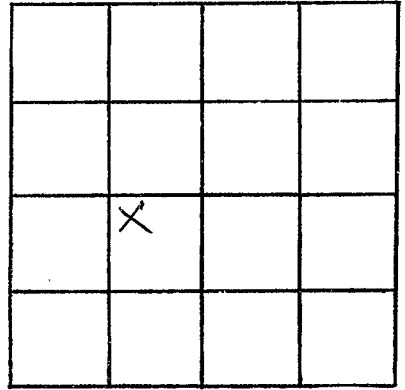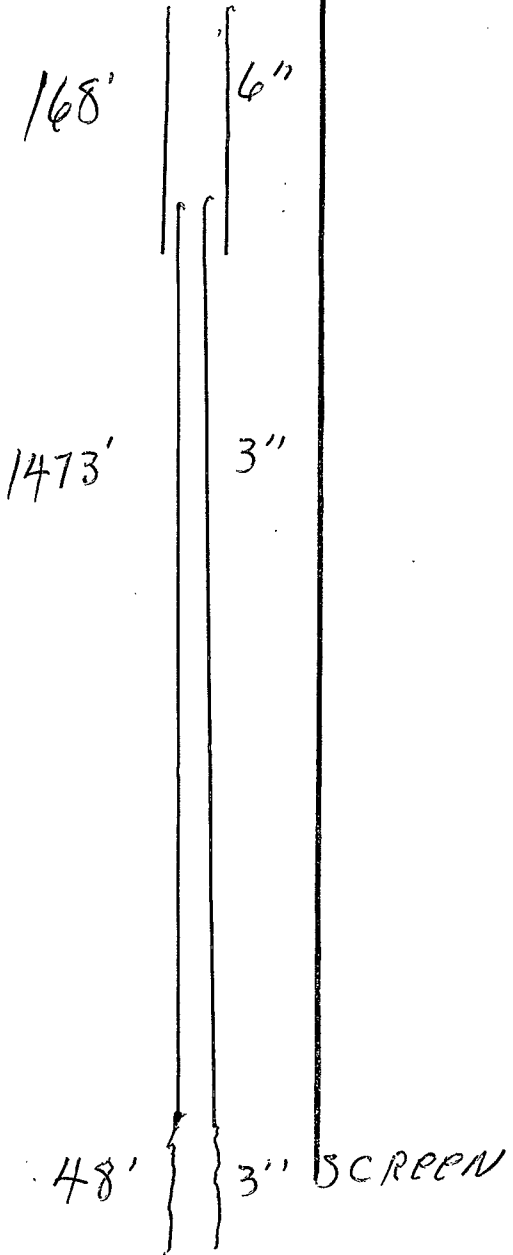

SECTION \_\_\_\_\_

Please indicate well location X.

ADDITIONAL INFORMATION

1473'  
168'  
48'  
3" SCREEN

If more than one screen, show locations of each on sketch.