

Tunica
H25
5-2-81

MISSISSIPPI
BOARD OF WATER COMMISSIONERS
416 North State Street
Jackson, Mississippi 39201

WATER WELL DRILLERS LOG

5-2 ✓ 19 81 Hester Drilling Tunica
date well completed firm name county well located

LANDOWNER: W.H. Hoston
Farms
Tunica, Miss
(mailing address)

description of formation encountered	CODED	from to	
Shale & Clay		0	4.3
fine sand		4.3	5.2
Coarse sand		5.2	10.3

WELL LOCATION:
sec. 6 T. 5 N. R. 10 E
5 1/2 miles S. East of Tunica
(distance) (direction) (nearest town)

WELL PURPOSE: Irrigation
(home, irrigation, municipal, industrial)

- WELL COMPLETION DATA:
- (1) diameter (inches) 16
 - (2) total depth (feet) 103
 - (3) static water level (feet) 15 below top of ground.
 - (4) casing Steel 63 (material) (depth)
 - (5) screen 40 63 (length) (depth to top)
 - (6) pump 60 2200 (HP) (yield gpm)
 - (7) electric log Diesel (type power)
 - (8) how well bottom plugged Steel plate

DRILLERS REMARKS:
Real Good
Foundation


DEPT. OF NATURAL RESOURCES
BUREAU OF LAND & WATER RESOURCES

MAY 28 1981

RECEIVED

If well telescopes please sketch and show depths.

GROUND LEVEL

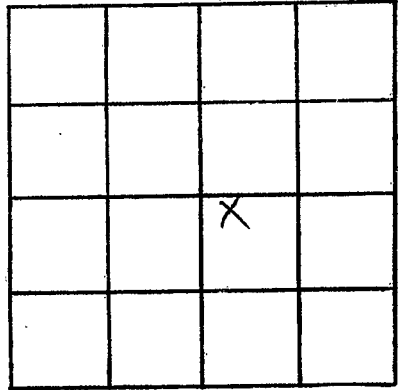

SECTION 6

Please indicate well location X.

ADDITIONAL INFORMATION

If more than one screen,
show locations of each on sketch.