

Tunica
H26
5-10-81
5-10

MISSISSIPPI
BOARD OF WATER COMMISSIONERS
416 North State Street
Jackson, Mississippi 39201

WATER WELL DRILLERS LOG

date well completed 1981 firm name Hester Drilling Tunica county well located

LANDOWNER: Gerald Swinell
Acorns
Tunica, Miss
(mailing address)

| description of formations encountered | CODED | from to | |
|---------------------------------------|-------|---------|-----|
| | | | |
| Clay & Sand | | 0 | 30 |
| Hard sand | | 30 | 53 |
| Coarse sand ↓ Gravel | | 53 | 103 |

WELL LOCATION:
sec. 9 T. 5 N. R. 10 E
7 miles East of Tunica
(distance) (direction) (nearest town)

WELL PURPOSE:
(home, irrigation, municipal, industrial)

- WELL COMPLETION DATA:
- (1) diameter (inches) 16
 - (2) total depth (feet) 103
 - (3) static water level (feet) 15 below top of ground.
 - (4) casing Steel, 63 (material) (depth)
 - ~~70~~ If telescope see back. (size)
 - (5) screen 40, 63 (length) (depth to top)
 - 16, Steel (size) (material)
 - (6) pump 600, 3000 (HP) (yield gpm)
 - Diesel (type power)
 - (7) electric log no (yes or no)
 - (organization running log)
 - (8) how well bottom plugged Steel plate

CODED

DEPT. OF NATURAL RESOURCES
BUREAU OF LAND & WATER RESOURCES


MAY 28 1981

RECEIVED

DRILLERS REMARKS: Good
formation
water bearing
sand

If well telescopes please sketch and show depths.

GROUND LEVEL

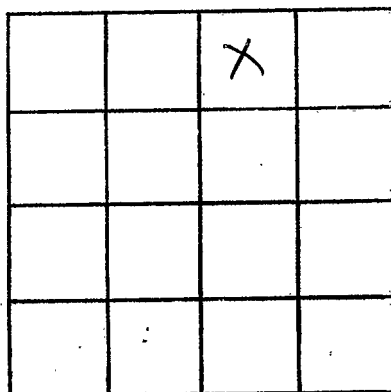

SECTION 7

Please indicate well location X.

ADDITIONAL INFORMATION

If more than one screen,
show locations of each on sketch.