

MISSISSIPPI DEPARTMENT OF NATURAL RESOURCES

Bureau of Land and Water Resources

Southport Mall

P.O. Box 10631

Jackson, Mississippi 39209

WATER WELL DRILLERS LOG

CODED

Imix  
H 27  
 CL-1737  
612 0/81

6/20 19 81 date well completed      LAYNE CENTARL CO. firm name      TUNICA county well located

LANDOWNER:	description of formations encountered	from	to
OWENS BROTHERS	clay	0	26
TUNICA, MS	c. sand &	26	50
(mailing address)	c. sand & pea gravel	50	75
	c. sand & gravel	75	122
WELL LOCATION: #7			
sec. 21 T 5 S R 10 W			
8 miles SE of Tunica			
(distance) (direction) (nearest town)			
WELL PURPOSE:			
(home irrigation municipal, industrial)			
WELL COMPLETION DATA:			
(1) diameter (inches) 32"			
(2) total depth (feet) 122'			
(3) static water level (feet) 15' below top of ground.			
(4) casing steel 72' (material) (depth)			
16" (size) If telescope see back.			
(5) screen 50' 72' (length) (depth to top)			
16" st. steel (size) (material)			
(6) pump 60 2400 (HP) (yield gpm)			
diesel (type power)			
(7) electric log no (yes or no)			
(organization running log)			
st. plate			
(8) how well bottom plugged			
DRILLERS REMARKS:			

CODED


MISSISSIPPI DEPARTMENT OF NATURAL RESOURCES  
 BUREAU OF LAND & WATER RESOURCES

JUN 24 1982

RECEIVED

If well telescopes please sketch and show depths.

GROUND LEVEL

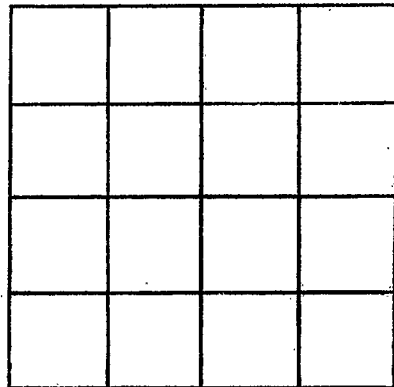

SECTION \_\_\_\_\_

Please indicate well location X.

ADDITIONAL INFORMATION

If more than one screen,  
show locations of each on sketch.