

**MISSISSIPPI  
BOARD OF WATER COMMISSIONERS**  
416 North State Street  
Jackson, Mississippi 39201

**CODED**

**WATER WELL DRILLERS LOG**

<i>Jurica</i>
<i>H 28</i>
CL-1737
<i>6/15/81</i>

6/15 19 81      LAYNE-CENTRAL CO.      TUNICA  
 date well completed      firm name      county well located

LANDOWNER:	description of formations encountered	from	to
Owens Brothers			
Tunica, MS	coarse sand	32	48
(mailing address)	c. sand & pea gravel	48	75
WELL LOCATION: # 6	c. sand & gravel	75	110
sec. 21 T 5 S R. 10 W	c. sand	110	122
8 miles SE of Tunica			
(distance) (direction) (nearest town)			
WELL PURPOSE:			
(home, irrigation, municipal, industrial)			
WELL COMPLETION DATA:			
(1) diameter (inches) 32"			
(2) total depth (feet) 122'			
(3) static water level (feet) 15' below top of ground.			
(4) casing steel 72' (material) (depth)			
16" (size) if telescope see back.			
(5) screen 50' 72' (length) (depth to top)			
16" st. steel (size) (material)			
(6) pump 60 2400 (HP) (yield gpm)			
diesel (type power)			
(7) electric log no (yes or no)			
(organization running log) st. plate			
(8) how well bottom plugged			
DRILLERS REMARKS:			

**CODED**


DEPT OF NATURAL RESOURCES  
BUREAU OF LAND & WATER RESOURCES

JUN 24 1982

**RECEIVED**

If well telescopes please sketch and show depths.

GROUND LEVEL

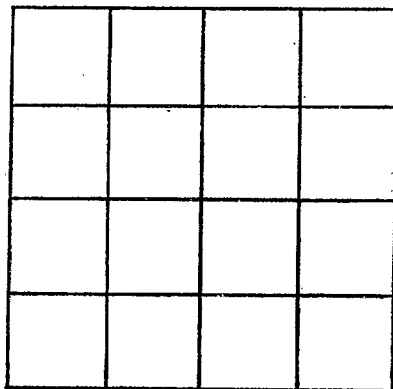

SECTION \_\_\_\_\_

Please indicate well location X.

ADDITIONAL INFORMATION

A series of horizontal lines providing space for additional information.

If more than one screen, show locations of each on sketch.