

H 30
 Tunica Co (Elev #15)
 9-26-83

MISSISSIPPI
 BOARD OF WATER COMMISSIONERS
 416 North State Street
 Jackson, Mississippi 39201

CODED

WATER WELL DRILLERS LOG

September 26 1983 Small Well Supply Sumner
 date well completed firm name county well located

LANDOWNER: Paul Battle

Magnolia Processing
Tunica, Ms.
 (mailing address)

WELL LOCATION:

sec. 30 T 5 N R 10 E
6 miles South of Tunica
 (distance) (direction) (nearest town)

WELL PURPOSE:

(home, irrigation, municipal, Industrial)

WELL COMPLETION DATA:

- (1) diameter (Inches) 6 by 4
- (2) total depth (feet) 1540
- (3) static water level (feet) 35 inflow above top of ground.
- (4) casing Steel 1490
 (material) (depth)
- 4 If telescope see back.
 (size)
- (5) screen 56 1490
 (length) (depth to top)
- 56 Stainless Steel
 (size) (material)
- (6) pump 15 200
 (HP) (yield gpm)
- elec
 (type power)
- (7) electric log yes
MS Natural Resources
 (organization running log)
- (8) how well bottom plugged Steel
BACK UP

description of formations encountered

from

to


<u>Some clay</u>	<u>0</u>	<u>60</u>
<u>course sandstone</u>	<u>60</u>	<u>124</u>
<u>clay</u>	<u>124</u>	<u>221</u>
<u>Sandy clay</u>	<u>221</u>	<u>254</u>
<u>SAND</u>	<u>254</u>	<u>351</u>
<u>clay</u>	<u>351</u>	<u>365</u>
<u>SAND & CLAY</u>	<u>365</u>	<u>320</u>
<u>clay</u>	<u>320</u>	<u>1010</u>
<u>SAND</u>	<u>1010</u>	<u>1190</u>
<u>clay</u>	<u>1190</u>	<u>1390</u>
<u>SAND</u>	<u>1390</u>	<u>1420</u>
<u>clay str. with sand</u>	<u>1420</u>	<u>1460</u>
<u>SAND</u>	<u>1460</u>	<u>1540</u>

Paul
2/21/84
gpr

DRILLERS REMARKS:

If well telescopes please
sketch and show depths.

GROUND LEVEL

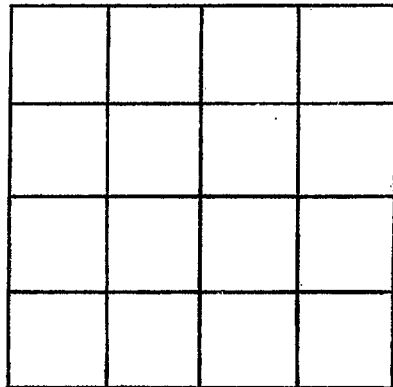

SECTION _____

Please indicate well location X.

ADDITIONAL INFORMATION

If more than one screen,
show locations of each on sketch.