

State Well Report

Part 1 - Driller's Log

Mississippi Department of Environmental Quality
Office of Land and Water Resources
P.O. Box 2309
Jackson, MS 39225
(601)961-5210
(601)961-5228 (fax)

County: Tunica
Permit #: GW-449551
Driller: Delta Drilling of Tunica
Date drilling completed: 6-7-11

For Office Use Only:

Aquifer: H 42
Well #: _____
L. S. Elevation: _____
E-log #: _____

State Law requires that this report be prepared by the license holder responsible for the work and filed with the Department at the above address within 30 days of completion of drilling of the well or borehole.

Information on Well Owner (Landowner if borehole is not for a water well)	Well or Borehole Location
Owner Name: <u>Mike Montgomery</u>	Latitude: <u>N34° 39' 40"</u> Longitude: <u>W90° 15' 39.2"</u>
Mailing Address: <u>Montgomery Ms. Trust</u> <u>PO Box 109</u>	Method of Lat/Long (circle one): <u>Hand-held GPS</u> , Conventional Survey, Survey-grade GPS
<u>Lumbrook</u> <u>AR.</u> <u>72353</u>	USGS quad: <u>40 1/4 SE 1/4 Sec 9</u> Twn <u>55</u> Rng <u>10W</u>
City State Zip Code	NE
Telephone No. ()	Distance Direction Nearest Town <u>8</u> Miles <u>East</u> of <u>Tunica</u>

Well / Borehole Data

Date drilling started: 6-7-11 Date drilling completed: 6-7-11 Hole depth: 110 Hole diameter: 28"

Location of the source of any surface water used for drilling: rice field next to well

Method of dosing and volume of Chlorine used in drilling and development: _____

Logs run (circle all applicable): No log run Electric Gamma Ray Density Sonic Neutron Other: _____

Name of organization running log(s): _____

Purpose of borehole (check one): Water Well Geotechnical/Geological Investigation _____ Ground Source Heat Pump _____

Seismic Survey _____ Other (describe) _____

If drilling is not related to water well construction, skip the remainder of this block

Purpose of Well (check one): Home _____ Industrial _____ Public Supply _____ Irrigation Fish Culture _____ Other: _____

If a flowing well, method of flow regulation: Valve _____ Other (describe) _____

Static Water Level: 24 feet above or below (circle one) land surface Date measured: 6-9-11

Method of Measurement (circle one): steel tape electric tape air line other: _____

Well depth: 110 Well grouted to a depth of 10 feet Type of grout (circle one): Neat Cement Bentonite Mix

Casing length: 30 feet Casing diameter: 16 inches Type of casing: PVC

Screen length: 60 feet Screen diameter: 16 inches Type of screen: PVC

Screen slot size: .050 inches Setting depth: From 50 feet to 110 feet

Type of completion (circle all applicable): Gravel packed Underreamed Telescoped Open hole Natural Development

Other (describe): _____

Top of lap pipe or reduction in casing: _____ feet. *If telescoped or more than one screen, describe on next page*


Form: OLWR-SWR-11A(10/09)

RECEIVED
JUL 28 2011
BY: OLWR

The sketch below only required for water wells


Description of formations encountered must be provided for all wells and boreholes, unless specifically exempted by regulations

If well telescopes, show depths on sketch.

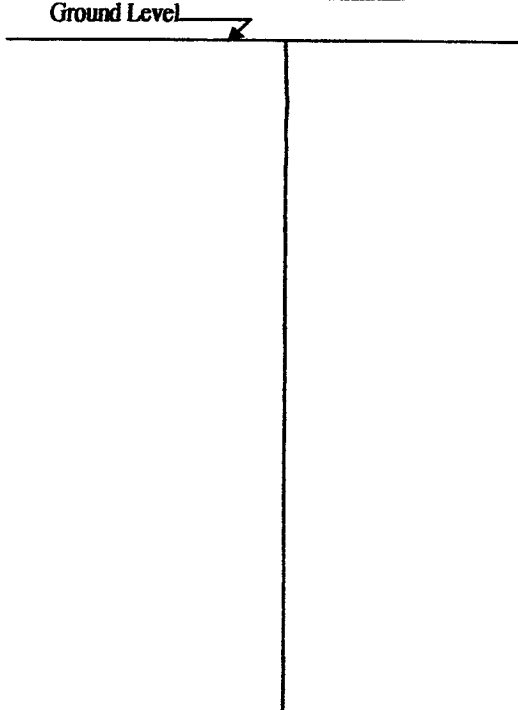

Description of Formations Encountered	From (depth)	To (depth)
Clay	Ground Level	43
Coarse Sand & gravel	44	110

If more than one screen, show location of each on sketch

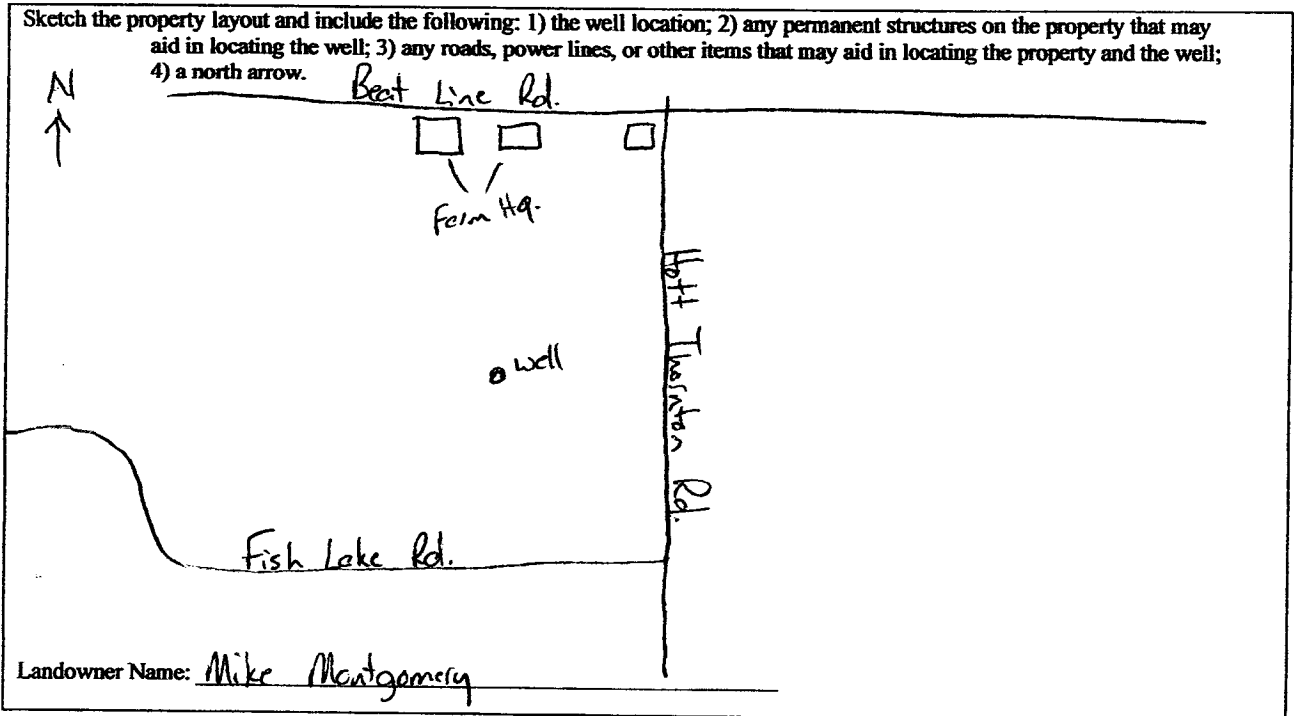

Form: OLWR-SWR-1A (04/08)

I certify that the well/borehole was drilled, constructed, and completed in accordance with all applicable requirements of the Mississippi Department of Environmental Quality and the Mississippi Department of Health regulations, if applicable, and state laws.

Chris Shockley # 2561 7-24-11
Print Name of Responsible Licensee and License No. Date

Chris Shockley
Signature of Licensee

RECEIVED

JUL 28 2011
BY: OLWR

STATE WELL REPORT

Part 2

Pump Installer's Completion Report
 Mississippi Department of Environmental Quality
 Office of Land and Water Resources
 P.O. Box 2309
 Jackson, MS 39225
 (601)961-5210
 (601)961-5228 (fax)

For Office Use Only:

Aquifer: _____

Well #: H42

Elevation: _____

County: Tunica

Permit #: GW-44955

Driller: Delta Drilling of Tunica

Date completed: 6-9-11

Copy information from block on Part 1

This part of the report must be completed by a licensed water well contractor or a licensed pump installer. A copy of Part 1 of the report must be attached and both parts filed with the Department at the above address within 30 days of well completion.

Well Owner Information	Well Location
Owner Name: <u>Mike Montgomery</u>	Latitude: <u>N34° 29.674'</u> Longitude: <u>W90° 15.392'</u>
Mailing Address: <u>Mont. Ms. Trust</u>	Method of Lat/Long (check one): Conventional Survey _____
<u>P.O. Box 109</u>	USGS quad _____, Hand-held GPS <input checked="" type="checkbox"/> , Survey-grade GPS _____
<u>Lombrook AR. 72353</u>	<u>NW 1/4 SE 1/4 Sec 9 T 55 R 10W</u>
City State Zip Code	<u>NE</u>
Telephone No. () _____	Distance Direction Nearest Town
	<u>5 Miles East of Tunica, MS.</u>

Pump Type	Power Type
Circle one	Circle one
Air Lift <input type="checkbox"/> Jet <input type="checkbox"/> Submersible <input type="checkbox"/>	<input checked="" type="checkbox"/> Diesel Engine <input type="checkbox"/> Gasoline Engine <input type="checkbox"/> Natural Gas
Bucket <input type="checkbox"/> Piston <input type="checkbox"/> <input checked="" type="checkbox"/> Turbine <input type="checkbox"/>	Electric Motor <input type="checkbox"/> Hand <input type="checkbox"/> Tractor PTO
Centrifugal <input type="checkbox"/> Rotary <input type="checkbox"/> Flowing Well <input type="checkbox"/>	Windmill <input type="checkbox"/> Other (specify): _____
Other (specify): _____	Horse Power Rating of Motor: <u>85</u>
Date Pump Installed: <u>6-9-11</u>	Setting Depth: <u>50</u> feet
Rated Pump Capacity: <u>3000</u> Gallons Per Minute	Number of Stages: <u>1</u>

Pump Test Data	Method of Measuring Water Level
	Circle one
Date Well Tested: _____	Air Line <input type="checkbox"/> Electric Measuring Line <input type="checkbox"/> <input checked="" type="checkbox"/> Steel Tape
Static Water Level (A): _____ Feet Below Land Surface	Other (specify): _____
Pumping Water Level (B): _____ Feet Below Land Surface	For flowing well, measured shut in head: _____ feet
Drawdown [(B) - (A)]: _____ Feet Below Land Surface	Well yielded _____ GPM with a drawdown of _____ feet after _____ hours of pumping
Test Pumping Rate: _____ Gallons Per Minute	
Duration of Pump Test (minimum 4 hours): _____ hours	

This is for (circle one): New Well Replacement of Existing Pump Repair of Existing Pump

I HEREBY CERTIFY that the above statements are true to the best of my knowledge.

Chris Shaddy # 2561
 Print Name of Pump Installer and License No. (if applicable)

[Signature]
 Signature of Pump Installer

RECEIVED
 JUL 28 2011
 Form: OLWR-SWR-1C (07-09)
 BY: OLWR