

# MISSISSIPPI DEPARTMENT OF NATURAL RESOURCES

Bureau of Land and Water Resources

COUNTY WELL LOCATED <b>Tunica</b>	
WELL NUMBER <b>H</b>	CODED
DATE WELL COMPLETED <b>2000</b> <b>12-8-87</b>	

PERMIT NUMBER
NAME OF DRILLING FIRM <b>HICKS WELL COMPANY</b>
RT. 1 BOX 157 <b>SENATOBIA, MISS.</b>

P.O. Box 10631  
Jackson, Mississippi 39209  
WATER WELL DRILLERS LOG

NAME & MAILING ADDRESS OF LANDOWNER <b>J.L. Dye</b> <b>Rt # 1</b> <b>Sarah, MS 38665</b>		
WELL LOCATION: SEC	TOWNSHIP	RANGE
<b>23</b>	<b>5</b>	<b>N 10 E</b> <b>S</b>
DISTANCE	DIRECTION	NEAREST TOWN
<b>1</b> Miles	<b>W</b>	<b>Savage</b>
OTHER LANDMARK		
WELL PURPOSE: <input checked="" type="checkbox"/> Home Irrigation, <input type="checkbox"/> Municipal, <input type="checkbox"/> Industrial, <input type="checkbox"/> Fish Pond, etc.		

PUMP DATA		
PUMP TYPE (Circle One): <input checked="" type="checkbox"/> Submersible, <input type="checkbox"/> Turbine, <input type="checkbox"/> Jet <input type="checkbox"/> Flowing Well, Other (Describe) _____		
POWER TYPE (Circle One): <input checked="" type="checkbox"/> Electric, <input type="checkbox"/> Tractor, <input type="checkbox"/> Diesel, <input type="checkbox"/> Gasoline, <input type="checkbox"/> Butane, Other (Describe) _____		
Pump Capacity (GPM)	No. of Stages	Setting Depth
<b>10</b>	<b>7</b>	<b>60'</b> FT.
PUMP TEST		
Well yielded _____ GPM with a drawdown of _____ ft. after _____ hours of pumping		

WELL DATA		
Well Depth <b>140'</b>	Casing Diameter (In.) <b>4"</b>	Casing Length (Ft.) <b>130'</b>
Type of Casing <b>PVC</b>	Hole Depth <b>140'</b>	Depth to Static Water Level <b>40'</b>
TYPE OF COMPLETION: (Circle One or More): Gravel Packed, <input type="checkbox"/> Underreamed, <input type="checkbox"/> Telescoped, Natural Development, <input type="checkbox"/> Open Hole, <input type="checkbox"/> Other (Describe) <b>PVC Cap</b>		
Top of Lap Pipe or Reduction in Casing <b>FEET</b> IF TELESCOPED OR MORE THAN ONE SCREEN: USE BACK PAGE		

LOG DATA	
TYPE OF LOG RUN (Circle One): <input type="checkbox"/> No Log Run, <input type="checkbox"/> Electric, <input type="checkbox"/> Gamma Ray, <input type="checkbox"/> Density, <input type="checkbox"/> Sonic, <input type="checkbox"/> Neutron, Other (Describe) _____	
Name of Organization Running Log	

GEOLOGIC DATA (Office Use Only)			
Surface Elev.	Geologic Unit	Unit Thickness	Depth to Top
Subs. SW	Date	Analysis	Aquifer Test


SCREEN DATA		
Diameter - Inches <b>4"</b>	Length - Feet <b>10'</b>	Slot Size - Inches <b>.013</b>
Screen Type <b>PVC</b>		Depth to Bottom - Feet <b>140'</b>

DRILLER'S REMARKS
DEC 21 1987
Department of Natural Resources Bureau of Land & Water Resources

DESCRIPTION OF FORMATIONS ENCOUNTERED	FROM	TO	FORMATIONS (Continued)	FROM	TO
<b>Black Humbo</b>	<b>0</b>	<b>10</b>			
<b>Black clay</b>	<b>10</b>	<b>60</b>			
<b>Army Sand</b>	<b>60</b>	<b>140</b>			

If well telescopes please sketch and show depths.

GROUND LEVEL

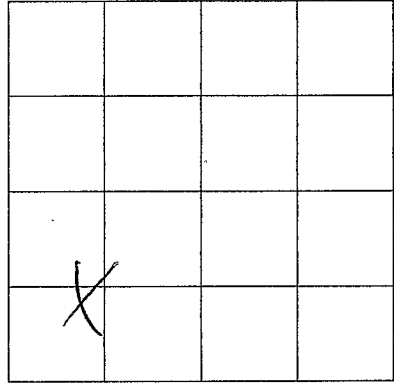

SECTION 03

Please indicate well location X.

ADDITIONAL INFORMATION

If more than one screen,  
show location of each on sketch.