

Tunica

MISSISSIPPI DEPARTMENT OF ENVIRONMENTAL QUALITY

Office of Land and Water Resources

COUNTY WELL LOCATED  
 WELLS NUMBER 7776 CODED  
 DATE WELL COMPLETED  
3-20-95

PERMIT NUMBER  
 NAME OF DRILLING FIRM  
**HICKS WELL CO.**  
 RT. 1 BOX 157  
 SENATOBIA, MS 38668

P. O. Box 10631  
 Jackson, MS 39289-0631  
 WATER WELL DRILLERS LOG

NAME & MAILING ADDRESS OF LANDOWNER  
David Ferrers

RT-1

Sarah, MS

WELL LOCATION: SEC 23 TOWNSHIP 5 RANGE N 10 E

DISTANCE 1/4 Miles 4 of Collierville

DIRECTION SE NEAREST TOWN

OTHER LANDMARK  
SAVAGE

WELL PURPOSE:  Home Irrigation, Municipal, Industrial, Fish Pond, etc.

PUMP DATA

PUMP TYPE (Circle One):  
 Submersible Turbine, Jet, Flowing Well,  
 Other (Describe) \_\_\_\_\_

POWER TYPE (Circle One):  
 Electric, Tractor, Diesel, Gasoline, Butane,  
 Other (Describe) \_\_\_\_\_ H/P 1/2

Pump Capacity (GPM) <u>10</u>	No. of Stages <u>9</u>	Setting Depth <u>600</u> FT.
----------------------------------	---------------------------	---------------------------------

PUMP TEST

Well yielded \_\_\_\_\_ GPM with  
 a drawdown of \_\_\_\_\_ ft.  
 after \_\_\_\_\_ hours of pumping

WELL DATA

Well Depth <u>90'</u>	Casing Diameter (In.) <u>4"</u>	Casing Length (Ft.) <u>80</u>
Type of Casing <u>PVC</u>	Hole Depth <u>90'</u>	Depth to Static Water Level <u>40'</u>

TYPE OF COMPLETION: (Circle One or More):  
 Gravel Packed, Underreamed, Telescoped,  
 Natural Development, Open Hole, Other  
 (Describe) \_\_\_\_\_

WELL GROUTED TO A DEPTH OF 10 FEET  
 Type Grout (circle one):  Cement, Bentonite, or Mix

SCREEN DATA

Diameter - Inches <u>10"</u>	Length - Feet <u>10'</u>	Slot Size - Inches <u>013</u>
Screen Type <u>PVC</u>	Depth to Bottom - Feet <u>10'</u>	

LOG DATA

TYPE OF LOG RUN (Circle One): No Log Run,  
 Electric, Gamma Ray, Density, Sonic, Neutron,  
 Other (Describe) \_\_\_\_\_

Name of Organization Running Log

GEOLOGIC DATA (Office Use Only)

Surface Elev.	Geologic Unit	Unit Thickness	Depth to Top
Subs. SWL	Date	Analysis	Aquifer Test

Driller's Remarks

Top of Lap Pipe or Reduction in Casing


FEET IF TELESKOPED OR MORE THAN ONE SCREEN: USE BACK PAGE

DESCRIPTION OF FORMATIONS ENCOUNTERED	FROM	TO
<u>Red sand</u>	<u>0</u>	<u>40</u>
<u>wh. to sand</u>	<u>40</u>	<u>90</u>

FORMATIONS (Continued)	FROM	TO
<b>RECEIVED</b>		
<b>JUL 24 1995</b>		
Dept. of Environmental Quality Office of Land & Water Resources		
IF MORE SPACE IS NEEDED, USE BACK		

If well telescopes please sketch and show depths.

GROUND LEVEL

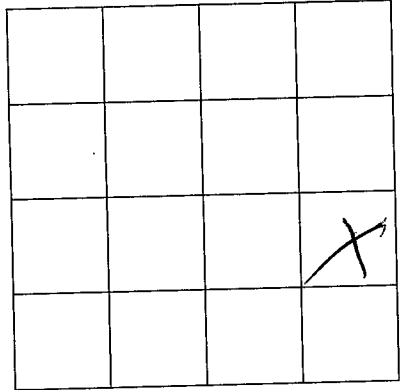

SECTION 23

Please indicate well location X.

ADDITIONAL INFORMATION

If more than one screen,  
show location of each on sketch.