

CODED 165

J 8
12-14-65

WATER WELL DRILLERS LOG

Jan 20 1967

Date: Dec. 14, 19 65, Driller: Layne-Central Company County Tunica

1582-85

(Name)

(1) Owner of Land: E. J. Lake, Inc.

(Name)

Dundee, Mississippi

(Address)

(2) Location: 1/4, 1/4, Sec. 13 14 24 T 6 R 2

 miles of Maud
(distance) (direction) (Nearest Town)

(3) Topography: flat

(Hilly) (Flat) (Level)

(4) Purpose of Well: domestic

(Domestic Irrigation
Municipal, Industrial, Other)

Information upon completion of well:

(1) Diameter 3 1/4 inches.

(2) Total Depth 1750' feet.

(3) Water Level flowing feet below top of ground.

(4) Cased to 104' 5", Size 3"
10" of 3 1/4 swage 4"

(5) Screen: Size 3", Length 40' 2"


(6) Were any formations sealed against pollution?

yes yes, no.

If YES depth of formation 75 lbs. shot at
bottom and packer above the screen
Why

Drillers Remarks:

Description & Color of Materials Sand, Clay, Red Clay, Shell; etc.	Thick- ness Feet	Depth Feet
Clay	32	32
Coarse sand	83	115
Gravel and sand	37	152
White clay	29	181
Blue clay	159	340
Fine sand & clay strks.	220	560
Clay	59	619
Rock	1	620
Sandy clay	7	627
Rock	1	628
Clay	17	645
Sand rock	103	648
Sand	10	658
Rock	11	659
Clay	21	680
Rock	1	681
Hard clay	120	801
Hard clay with sandy strks.	64	865
Rock	2	867
Clay	208	1075
Sandy clay	5	1080
Sand, small clay strks.	71	1151
Clay	76	1227
Rock	1	1228
Shale with sandy strks.	128	1356
Sandy clay	23	1379
Hard clay	41	1420
Hard clay with sandy strks.	82	1502
Sandy shale	12	1514
Hard shale	36	1550
Sandy shale	25	1575
(Over)		Well No.

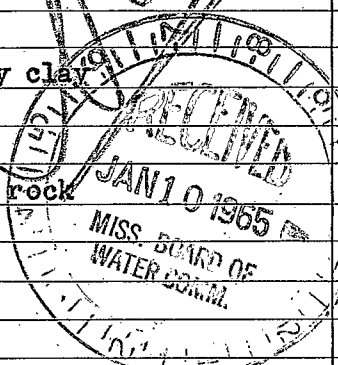

CODED

(Use Back Side)

Fine sandy clay
Fine sand
Clay

45 1620
123 1743
7 1750