

J 11

CODED
4/11/16
C276

8-10-56

WATER WELL DRILLERS LOG

Date: August 10, 19 56, Driller: Layne-Central Company County Tunica

2168

(Name)

(1) Owner of Land: C. R. Frank

(Name)

Maud, Mississippi

(Address)

(2) Location: 1/4, 1/4, Sec. 13 T. 6 R. 2

1 miles south of Maud

(distance)

(direction)

(Nearest Town)

(3) Topography: flat

(Hilly)

(Flat)

(Level)

(4) Purpose of Well: irrigation

(Domestic Irrigation
Municipal, Industrial, Other)

Description & Color of Materials Sand, Clay, Red Clay, Shell, etc.	Thick- ness Feet	Depth Feet
Clay	28	28
Fine sand & clay balls	7	35
Fine sand	7	42
Coarse sand	10	52
Coarse sand & pea gravel	10	62
Coarse sand	10	72
Sand & pea gravel	10	82
Sand & gravel	3	85
Sand & gravel	27	112

Information upon completion of well:

(1) Diameter 16x12 inches.

(2) Total Depth 112 feet.

(3) Water Level 17' - 11" feet below top of ground.

(4) Cased to 60' Size 16" 2' swage

(5) Screen: Size 12" Length 50'

(6) Were the formations sealed against pollution?

yes, no no.

If YES depth of formation


Why

Drillers Remarks:

1200 GPM

engine drive

CODED

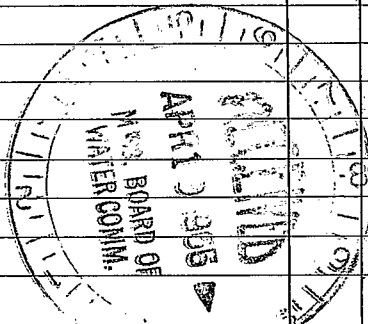

(Use Back Side)

Well No.

100