

TUNICA MISSISSIPPI BOARD OF WATER COMMISSIONERS

J 12

10-19-65

WATER WELL DRILLERS LOG

165
10/19/65
CODED
6

Date: October 19, 1965, Driller: Layne-Central Company County Tunica

(Name)

(1) Owner of Land: E. M. Hood, Jr.
(Name)

Dundee, Mississippi
(Address)

(2) Location: NE 1/4, 1/4, Sec. 22 T6 R12

8 miles southwest of Tunica
(distance) (direction) (Nearest Town)

(3) Topography: flat
(Hilly) (Flat) (Level)

(4) Purpose of Well: irrigation
(Domestic Irrigation
Municipal, Industrial, Other)

Description & Color of Materials Sand, Clay, Red Clay, Shell, etc.	Thick- ness Feet	Depth Feet
Clay	20	20
Coarse sand	20	40
Coarse sand, pea gravel	35	75
Coarse sand, boulders	36	111

CODED

Information upon completion of well:


- (1) Diameter 12 inches.
- (2) Total Depth 111 feet.
- (3) Water Level 14 feet below top of ground.
- (4) Cased to 81', Size 12"
- (5) Screen: Size 12", Length 30'
- (6) Were any formations sealed against pollution?

no yes, no no.

If YES depth of formation _____

Why _____

Drillers Remarks: _____

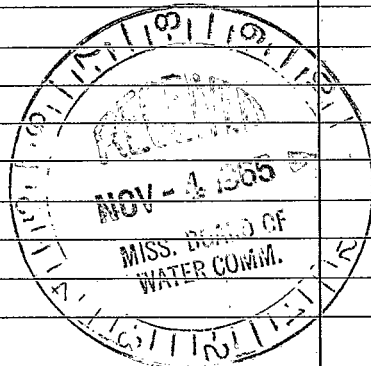

(Use Back Side)

Well No.

1000