

Tunica
T 15
10-67

MISSISSIPPI
 BOARD OF WATER COMMISSIONERS
 416 North State Street
 Jackson, Mississippi 39201

CODED

WATER WELL DRILLERS LOG

10-23-67 1967 Live Court James, Ar. Tunica
 date well completed firm name county well located

LANDOWNER: Boyd Bass
@ Clayton Miss

description of formations encountered	from	to
<u>Top Soil + Clay + Sand</u>		<u>14'</u>
<u>Clay</u>		<u>30 1/2'</u>
<u>Med. Sand</u>		<u>40'</u>
<u>Coarse Sand</u>		<u>53'</u>
<u>Sand + Pea rock</u>		<u>79'</u>
<u>Sand + Gravel</u>		<u>79'</u>
<u>Fine Sand</u>	<u>1 1/2'</u>	<u>100'</u>
<u>Coarse Sand + Gravel</u>		<u>115'</u>
<u>rock</u>		


(mailing address)

WELL LOCATION:
 sec 1 T. 6 N R. 12 E
S W
1/2 miles S of Clayton
 (distance) (direction) (nearest town)

WELL PURPOSE: Fish Regulator
 (home, irrigation, municipal, industrial)

WELL COMPLETION DATA:

- (1) diameter (inches) 6
- (2) total depth (feet) 111'
- (3) static water level (feet) 11' above top of ground.
- (4) casing Pipe 63'
 (material) (depth)
- 6 If telescope see back.
 (size)
- (5) screen 48' 63'
 (length) (depth to top)
- 10' Down 10'
 (size) (material)
- (6) pump 40 1000 GPM
 (HP) (yield gpm)
- Tractor
 (type power)
- (7) electric log _____
 (yes or no)
- _____
 (organization running log)
- (8) how well bottom plugged welded

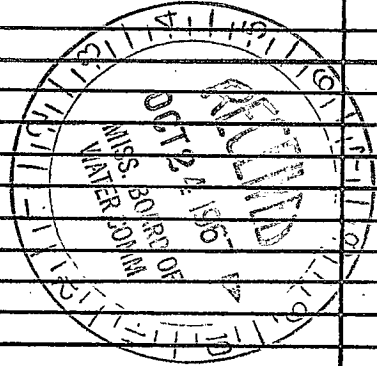


CODED

DRILLERS REMARKS:

If well telescopes please sketch and show depths.

GROUND LEVEL

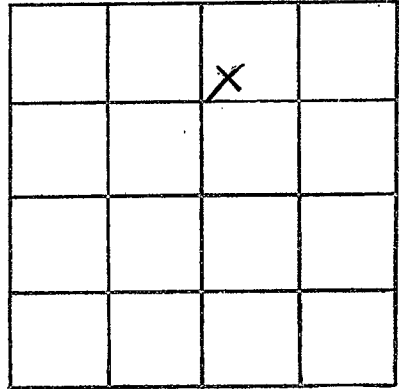

SECTION 1

Please indicate well location X.

ADDITIONAL INFORMATION

If more than one screen,
show locations of each on sketch.