

TUNICA
 J16
 4-68

MISSISSIPPI
 BOARD OF WATER COMMISSIONERS
 416 North State Street
 Jackson, Mississippi 39201

CODED

WATER WELL DRILLERS LOG

April 30 1968 Five County Farmers Assn - Tunica
 date well completed firm name county well located

LANDOWNER: Bonds Merc Co
 Chickadee
 Miss -
 (mailing address)

WELL LOCATION:
 sec. 18 T. 6 N. R. 12 E. S. W.
 5 miles NW of Dundee
 (distance) (direction) (nearest town)


WELL PURPOSE:
 (home, irrigation, municipal, industrial)

WELL COMPLETION DATA:

- (1) diameter (inches) 6
- (2) total depth (feet) 126.2
- (3) static water level (feet) 12.5 below top of ground.
- (4) casing Pipe, 78.2
 (material) (depth)
6 if telescope see back.
 (size)
- (5) screen 48, 78.2
 (length) (depth to top)
6, Dozer 101
 (size) (material)
- (6) pump 40, 1200
 (HP) (yield gpm).
 (type power)
- (7) electric log _____
 (yes or no)
 (organization running log)
- (8) how well bottom plugged Welded

description of formations encountered	from	to
Topsoil - Sandy		14
Clay		40
FINE SAND + Clay streak		53
FINE SAND		72.2
Med Sand		79
Sandy Gravel		78.2
Streak Clay + Sand		105
Sand + Gravel		131

CODED

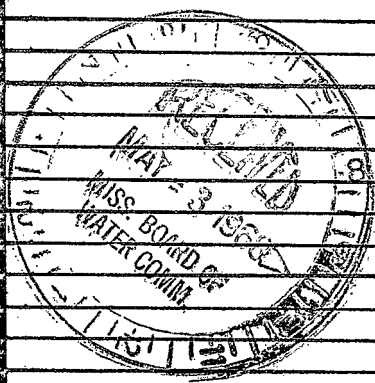

DRILLERS REMARKS:

