

TUNICA  
J17  
1-17-75

MISSISSIPPI  
BOARD OF WATER COMMISSIONERS  
416 North State Street  
Jackson, Mississippi 39201 **CODED**

WATER WELL DRILLERS LOG

1-17 1975 HRSTER Drilling Co Tunica  
date well completed firm name county well located

LANDOWNER: <u>Edgar Hood III</u>	description of formations encountered	from	to
<u>Dundee, Miss.</u>	<u>clay</u>	<u>0</u>	<u>22</u>
(mailing address)	<u>fine sand</u>	<u>22</u>	<u>46</u>
WELL LOCATION:	<u>COARSE SANDSTONE</u>	<u>46</u>	<u>103</u>
sec. <u>21</u> T. <u>6</u> N. R. <u>12</u> E. <sup>E 156</sup>			
<u>1 1/2</u> miles <u>NW</u> of <u>Dundee</u> (distance) (direction) (nearest town)			
WELL PURPOSE: (home, irrigation, municipal, industrial)			
WELL COMPLETION DATA:			
(1) diameter (inches) <u>12"</u>			
(2) total depth (feet) <u>103</u>			
(3) static water level (feet) <u>10</u> <sup>below</sup> <sub>above</sub> top of ground.			
(4) casing <u>steel</u> , <u>103</u> , (material) (depth)			
<u>12</u> if telescope see back. (size)			
(5) screen <u>40ft.</u> , <u>63</u> (length) (depth to top)			
<u>12</u> , <u>steel</u> (size) (material)			
(6) pump <u>40</u> <u>2000</u> (HP) (yield gpm)			
<u>Electric</u> (type power)			
(7) electric log <u>NO</u> (yes or no)			
(organization running log)			
(8) how well bottom plugged <u>plastic</u>			
DRILLERS REMARKS:			


**CODED**

RECEIVED  
MAR 10 1975

MISS. BD. OF WATER COMM

If well telescopes please sketch and show depths.

GROUND LEVEL

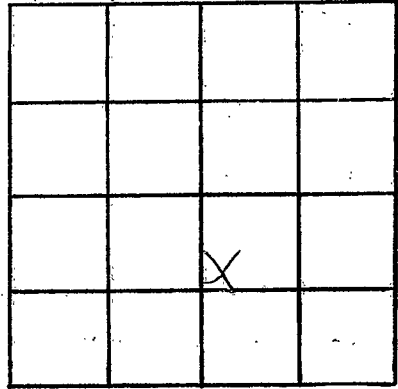

SECTION \_\_\_\_\_

Please indicate well location X.

ADDITIONAL INFORMATION

If more than one screen, show locations of each on sketch.