

TUNICA
 J 18
 4-12-80

MISSISSIPPI
 BOARD OF WATER COMMISSIONERS
 416 North State Street
 Jackson, Mississippi 39201

CODED

WATER WELL DRILLERS LOG

4-12-80 19 HESTER Drilling Co Tunica
 date well completed firm name county well located

LANDOWNER: CLARENCE CAIN
 Tunica, MS.
 (mailing address)

description of formations encountered	from	to
CLAY	0	35
fine sand	35	50
coarse sand & gravel	50	100

WELL LOCATION:
 sec 24 T 7 N R 12 E
 2 miles SE of Maud
 (distance) (direction) (nearest town)

WELL PURPOSE: Irrigation
 (home, irrigation, municipal, industrial)

- WELL COMPLETION DATA:
- (1) diameter (inches) 12"
 - (2) total depth (feet) 100
 - (3) static water level (feet) 14 below top of ground.
 - (4) casing steel 100' (material) (depth)
 12" (size) if telescope see back.
 - (5) screen 10' 100' (length) (depth to top)
 12 (size) steel (material)
 - (6) pump 30 2000 (HP) (yield gpm)
 electric (type power)
 - (7) electric log no (yes or no)

CODED

(organization running log)

(8) how well bottom plugged photo

DRILLERS REMARKS:


DEPT. OF NATURAL RESOURCES
 BUREAU OF LAND & WATER RESOURCES

MAY 28 1980

RECEIVED

If well telescopes please sketch and show depths.

GROUND LEVEL

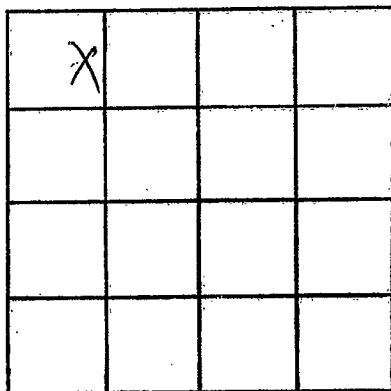

SECTION 24

Please indicate well location X.

ADDITIONAL INFORMATION

If more than one screen,
show locations of each on sketch.