

TUNICA

J 32

8-15-80

8-15

1980

Alstra Drilling

Tunica

MISSISSIPPI BOARD OF WATER COMMISSIONERS
416 North State Street
Jackson, Mississippi 39201

CODED

WATER WELL DRILLERS LOG

date well completed

firm name

county well located

LANDOWNER: Loyd Ryals

Dundee MS

description of formations encountered

from

to

(mailing address)

WELL LOCATION:

sec. 26 T 5 R 12

1 miles nw of Dundee
(distance) (direction) (nearest town)

WELL PURPOSE: Irrigation
(home, irrigation, municipal, industrial)

WELL COMPLETION DATA:

- (1) diameter (inches) 12"
- (2) total depth (feet) 103'
- (3) static water level (feet) 17' below/above top of ground.
- (4) casing steel, 103'
(material) (depth)
12" if telescope see back.
(size)
- (5) screen 40', 103'
(length) (depth to top)
12, steel
(size) (material)
- (6) pump 40 2000
(HP) (yield gpm)
Direct
(type power)
- (7) electric log no
(yes or no)

(organization running log)

(8) how well bottom plugged steel plate

DRILLERS REMARKS:


DEPT. OF NATURAL RESOURCES
BUREAU OF LAND & WATER RESOURCES

OCT -7 1980

RECEIVED

If well telescopes please sketch and show depths.

GROUND LEVEL

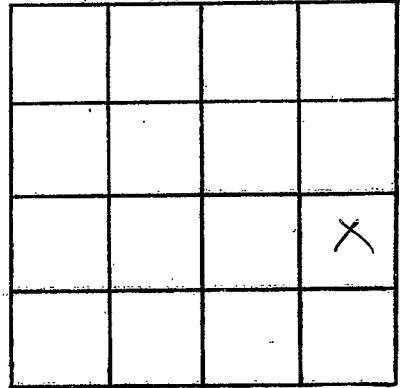

SECTION 26

Please indicate well location X.

ADDITIONAL INFORMATION

If more than one screen,
show locations of each on sketch.