

TUNICA

J 33

8-12-80

8-2-

MISSISSIPPI BOARD OF WATER COMMISSIONERS
416 North State Street
Jackson, Mississippi 39201

CODED

WATER WELL DRILLERS LOG

date well completed

1980

Areston Drilling Co

firm name

Tunica

county well located

LANDOWNER: John White
Dunder, MS
(mailing address)

description of formations encountered	from	to
clay	0'	15'
fine sand	15'	60'
coarse sand	60'	110'

WELL LOCATION:
sec. 19 T 5 N R 12 E
SW W
5 miles W of Dunder
(distance) (direction) (nearest town)

WELL PURPOSE: Irrigation
(home, irrigation, municipal, industrial)

- WELL COMPLETION DATA:
- (1) diameter (inches) 16"
 - (2) total depth (feet) 110 ft.
 - (3) static water level (feet) 18 below top of ground.
 - (4) casing steel, 70 ft. (material) (depth)
 - 16" if telescope see back. (size)
 - (5) screen 40 ft., 70 ft. (length) (depth to top)
 - 16" steel (size) (material)
 - (6) pump 60 HP, 2200 (HP) (yield gpm)
 - Direct (type power)
 - (7) electric log NO (yes or no)
 - (organization running log)
 - (8) how well bottom plugged steel plate

DEPT. OF NATURAL RESOURCES
BUREAU OF LAND & WATER RESOURCES


OCT - 7 1980

RECEIVED

DRILLERS REMARKS:

If well telescopes please sketch and show depths.

GROUND LEVEL

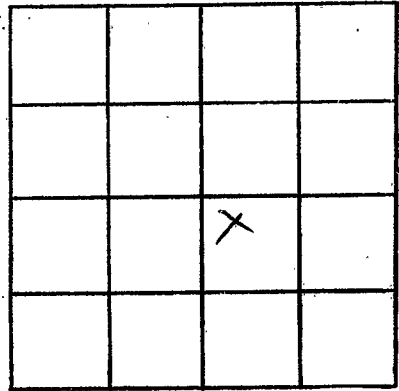

SECTION 19

Please indicate well location X.

ADDITIONAL INFORMATION

If more than one screen,
show locations of each on sketch.