

Tunica

J 35

2/6/81

Feb 6


date well completed

MISSISSIPPI BOARD OF WATER COMMISSIONERS
416 North State Street
Jackson, Mississippi 39201

WATER WELL DRILLERS LOG

81 Fin Co. Form Area

firm name

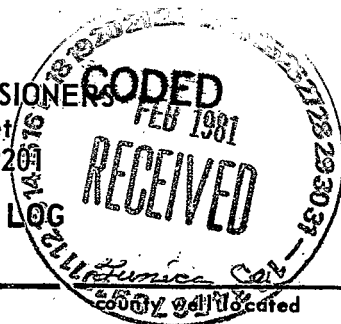

LANDOWNER: J. E. Sider

Desdemona

(mailing address)

WELL LOCATION:

sec. 16 T 6 N R 12 E
S W
3 miles N.W. of Desdemona
(distance) (direction) (nearest town)

WELL PURPOSE:

(home, irrigation, municipal, industrial)

WELL COMPLETION DATA:

- (1) diameter (inches) 12"
- (2) total depth (feet) 112
- (3) static water level (feet) 14 below top of ground.
- (4) casing Steel 62 (material) (depth)
12 (size) if telescope see back.
- (5) screen 50' 62' (length) (depth to top)
12" Steel-60 Stat (size) (material)
- (6) pump 60 1250 (HP) (yield gpm)
Diesel (type power)
- (7) electric log NO (yes or no)
(organization running log)
- (8) how well bottom plugged sealed

description of formations encountered

from

to

Top sand	0	10
Med sand	10	29
Coarse sand	29	48
Sand & silt	48	112


DRILLERS REMARKS:

DEPT. OF NATURAL RESOURCES
BUREAU OF LAND & WATER RESOURCES

FEB 23 1981
RECEIVED

If well telescopes please sketch and show depths.

GROUND LEVEL

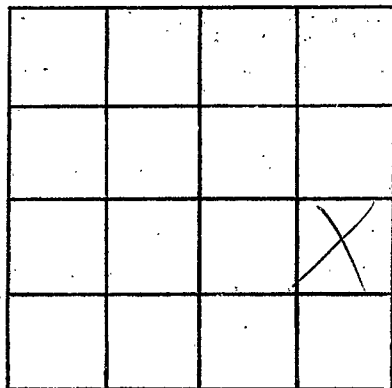

SECTION _____

Please indicate well location X.

ADDITIONAL INFORMATION

If more than one screen,
show locations of each on sketch.