

Junica
J51
3-28-69

MISSISSIPPI
 BOARD OF WATER COMMISSIONERS
 416 North State Street
 Jackson, Mississippi 39201

CODED

WATER WELL DRILLERS LOG

3-28 1969 J.H. ABEL + SON TUNICA
 date well completed firm name county well located

LANDOWNER: MR R.A. LAKE

description of formations encountered	from	to
CLAY + SHALE	1'	10'
SHALE + SILT	10'	20'
FINE SAND + SILT	20'	35'
FINE SAND	35'	40'
MED SAND	40'	60'
COARSE SAND & ALL	-	-
FINE GRAVEL	60'	84'

Down DEE MISSISSIPPI
 (mailing address)

WELL LOCATION:
 sec. 14 T. 6 S. R. 12 W.
0 miles AT of MAUD
 (distance) (direction) (nearest town)

WELL PURPOSE: FISH PONDS
 (home, irrigation, municipal, industrial)

WELL COMPLETION DATA:

- (1) diameter (inches) 4" ID
- (2) total depth (feet) 84 FEET
- (3) static water level (feet) 10' below top of ground.
- (4) casing 4" GALV (material), 63' (depth),
4" (size) if telescope see back.
- (5) screen 21' (length), 63' (depth to top),
4" (size), SS. UNDERBAR (material)
- (6) pump 2 HP (HP), 150 GPM (yield gpm)
ELECTRIC MOTOR (type power)
- (7) electric log NO (yes or no)
 (organization running log)
- (8) how well bottom plugged STEEL

CODED

NOTED


MAR 24 1969

MISS. DIV. OF WATER CONTROL

DRILLERS REMARKS: THIS LOG
MAY BE OF SOME THIS
WELL WAS ABANDERED
DOWN.

If well telescopes please sketch and show depths.

GROUND LEVEL

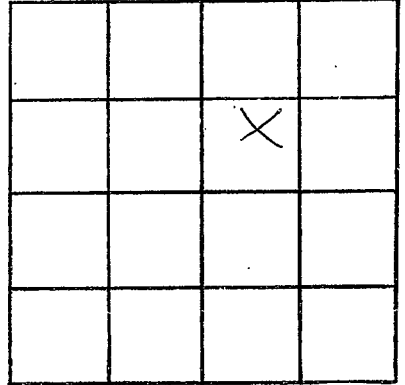

SECTION 14

Please indicate well location X.

ADDITIONAL INFORMATION

WELL USED TO PUMP
WATER FOR SMALL
FISH PONDS

PUMP 2 HP 1PH 1760
RPM BERKELEY SELF
PRIMEING PUMP
ELECTRIC MOTOR DRIVEN

3" SIZE

4"

STRAIGHT

WELL

8 1/2' DEEP

20' H"

WESCO

STAINLESS

CUNDER BAR

SCAFED

WELL RIGGED

DOWN

If more than one screen,
show locations of each on sketch.