

CODED

CODED  
JR  
C2970

MISSISSIPPI  
BOARD OF WATER COMMISSIONERS  
416 North State Street  
Jackson, Mississippi 39201  
WATER WELL DRILLERS LOG

TUNICA  
J 52  
7-27-69

July 27, 19 69 Layne-Central Company Tunica  
date well completed firm name county well located

LANDOWNER: Dutch Parker  
  
Dundee, Mississippi  
(mailing address)

description of formations encountered	from	to
Clay	0	40
Coarse sand, pea gravel	40	65
Coarse sand, gravel	65	93

WELL LOCATION: 6 S  
sec. 35 T R 12 W  
Dundee  
(distance) miles (direction) of (nearest town)

WELL PURPOSE: irrigation  
(home, irrigation, municipal, industrial)

WELL COMPLETION DATA:  
(1) diameter (inches) 16 x 12  
(2) total depth (feet) 93  
(3) static water level (feet) 11' 6" below top of ground  
(4) casing 2' of 16" x 12" swage steel, 50' (material), (depth), 16" (size) if telescope see back.  
(5) screen 40' , 93' (length), (depth to top) 12" (size), Armco (material)  
(6) pump 50 (HP), 2000 (yield gpm) engine (type power)  
(7) electric log no (yes or no)  
(organization running log)  
(8) how well bottom plugged platee

CODED


NOV 26 1969

MISS. BD. OF  
WATER COMMISSIONERS

DRILLERS REMARKS:

If well telescopes please sketch and show depths.

GROUND LEVEL

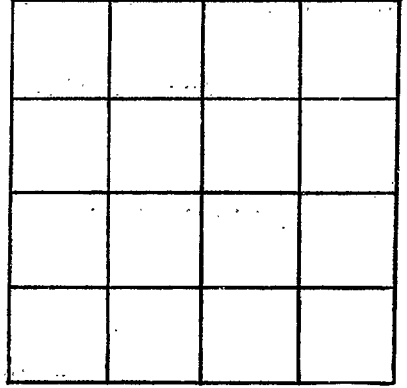

SECTION \_\_\_\_\_

Please indicate well location X.

ADDITIONAL INFORMATION

If more than one screen, show locations of each on sketch.