

**TUNICA**  
 J 54  
 9-23-69

MISSISSIPPI  
 BOARD OF WATER COMMISSIONERS  
 416 North State Street  
 Jackson, Mississippi 39201

CODED  
**CODED**  
 C3025

**WATER WELL DRILLERS LOG**

September 23, 1969 Lavne-Central Company Tunica  
 date well completed firm name county well located

LANDOWNER:	description of formations encountered	from	to
Milton Boyd			
Maud, Mississippi	Coarse sand	8	30
Tunica, Mississippi	Coarse sand, pea gravel	30	80
(mailing address)	Coarse sand, gravel	80	102

**WELL LOCATION:**  
 sec. 1 T. 6 N. R. 12 E  
 8 miles SW of Tunica  
 (distance) (direction) (nearest town)

**WELL PURPOSE:** irrigation  
 (home, irrigation, municipal, industrial)

- WELL COMPLETION DATA:**
- (1) diameter (inches) 12
  - (2) total depth (feet) 102
  - (3) static water level (feet) 23 below above top of ground.
  - (4) casing steel 62' (material), (depth)  
 12" if telescope see back. (size)
  - (5) screen 40' 102' (length), (depth to top)  
 12" Armco (size), (material)
  - (6) pump 30 1500 (HP), (yield gpm)  
 electric (type power)
  - (7) electric log no (yes or no)  
 (organization running log)
  - (8) how well bottom plugged plate


**CODED**

NOV 26 1969

DRILLERS REMARKS:  
 MISS. BD. OF WATER COMM.

If well telescopes please  
sketch and show depths.

GROUND LEVEL

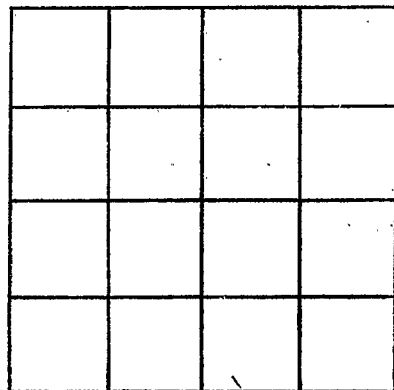

SECTION \_\_\_\_\_

Please indicate well location X.

ADDITIONAL INFORMATION

If more than one screen,  
show locations of each on sketch.