

TONICA

J56

9-21-70

MISSISSIPPI
 BOARD OF WATER COMMISSIONERS
 416 North State Street
 Jackson, Mississippi 39201

CODED

WATER WELL DRILLERS LOG

9/21

1970

J. H. ADDEL & SON, Inc

TONICA

date well completed

firm name

county well located

LANDOWNER: HOOD FARMS, Inc

description of formations encountered

from to

Box 295

CLAY & Gravel

1 49

TONICA MISSISSIPPI
(mailing address)

FINE SAND

49 65

MED. SAND

65 88

WELL LOCATION:

sec. 9 T. 6 S. R. 12 E. W.

1/2 miles S of DUNDY

(distance) (direction) (nearest town)

WELL PURPOSE:

(home, irrigation, municipal, industrial)

WELL COMPLETION DATA:

- (1) diameter (inches) 2"
- (2) total depth (feet) 88'
- (3) static water level (feet) 25 below above top of ground.
- (4) casing GALV PIPE, 8H' (material), (depth)
- 2" (size) if telescope see back.
- (5) screen 4' (length), 8H' (depth to top)
- 1/2" (size), DRIVE POINT (material)
- (6) pump HAND PUMP (HP) (yield gpm)
- (type power)
- (7) electric log NO (yes or no)
- (organization running log)

CODED

SEP 28 1970

(8) how well bottom plugged


DRIVE POINT

MISS. BD. OF
WATER COMM.

DRILLERS REMARKS:

If well telescopes please sketch and show depths.

GROUND LEVEL

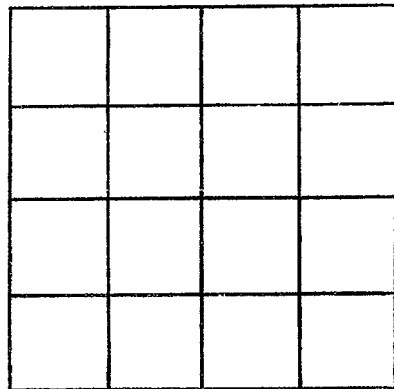

SECTION _____

Please indicate well location X.

ADDITIONAL INFORMATION

If more than one screen,
show locations of each on sketch.