

MISSISSIPPI DEPARTMENT OF NATURAL RESOURCES

Bureau of Land and Water Resources

Southport Mall

P.O. Box 10631

CODED

Jackson, Mississippi 39209

WATER WELL DRILLERS LOG

TUNICA  
8 104  
5713182

5-13 1982 Hester Mullis Tunica  
 date well completed firm name county well located

LANDOWNER: J.M. Boyd  
RT

Blunk, Miss  
 (mailing address)

WELL LOCATION:  
 sec. 17 T 6 N R 12 E  
4 miles North of Blunk  
 (distance) (direction) (nearest town)

WELL PURPOSE: Art. Farm  
 (home, irrigation, municipal, industrial)

WELL COMPLETION DATA:

(1) diameter (inches) 8  
 (2) total depth (feet) 103  
 (3) static water level (feet) 18 below above top of ground.  
 (4) casing plastic 63  
 (material) (depth)  
N/A if telescope see back.  
 (size)  
 (5) screen 40 63  
 (length) (depth to top)  
8 plastic  
 (size) (material)  
 (6) pump 20 1300  
 (HP) (yield gpm)  
chart  
 (type power)  
 (7) electric log no  
 (yes or no)  
no  
 (organization running log)  
 (8) how well bottom plugged plastic cap

Description of formations encountered	from	to
<u>Gravel</u>	<u>0</u>	<u>18</u>
<u>Soft Mud</u>	<u>18</u>	<u>31</u>
<u>Clay</u>	<u>31</u>	<u>49</u>
<u>Fine sand</u>	<u>49</u>	<u>60</u>
<u>Coarse sand</u>	<u>60</u>	<u>103</u>

CODED


DEPT. OF NATURAL RESOURCES  
 BUREAU OF LAND & WATER RESOURCES

OCT 11 1982  
 RECEIVED

DRILLERS REMARKS:

If well telescopes please sketch and show depths.

GROUND LEVEL

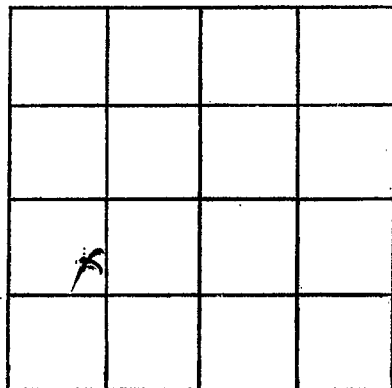

SECTION 17

Please indicate well location X.

ADDITIONAL INFORMATION

If more than one screen,  
show locations of each on sketch.