

State Well Report
Part 1 - Driller's Log
 Mississippi Department of Environmental Quality
 Office of Land and Water Resources
 P.O. Box 2309
 Jackson, MS 39225
 (601)961-5210
 (601)961-5228 (fax)

For Office Use Only:

Aquifer: J III
 Well #: _____
 L. S. Elevation: _____
 E-log #: _____

County: Tunica
 Permit #: GW-44000
 Driller: Delta Drilling of Tunica
 Date drilling completed: 4-10-10

State Law requires that this report be prepared by the license holder responsible for the work and filed with the Department at the above address within 30 days of completion of drilling of the well or borehole.

<p align="center">Information on Well Owner (Landowner if borehole is not for a water well)</p> <p>Owner Name: <u>Patrick Johnson</u> Mailing Address: <u>P.O. Box 457</u> <u>Tunica, MS. 38676</u> City State Zip Code Telephone No. <u>(662) 357-5025</u></p>	<p align="center">Well or Borehole Location</p> <p>Latitude: <u>N34° 35' 83"</u> Longitude: <u>W90° 25' 81"</u> Method of Lat/Long (circle one): <u>Hand-held GPS</u> Conventional Survey, <u>58</u> USGS quad: <u>Hand-held GPS</u> Survey-grade GPS <u>NW</u> <u>1/4</u> NE <u>1/4</u> Sec <u>2</u> Twn <u>6S</u> Rng <u>12W</u> Distance Direction Nearest Town <u>2</u> Miles <u>West</u> of <u>Clayton, MS</u></p>
--	---

Well / Borehole Data

Date drilling started: 4-10-10 Date drilling completed: 4-10-10 Hole depth: 100' Hole diameter: 30

Location of the source of any surface water used for drilling: 1/4 mile North - Beaver Dam Lake
 Method of dosing and volume of Chlorine used in drilling and development: 2 gallons bleach to water Truck loads

Logs run (circle all applicable): No log run Electric Gamma Ray Density Sonic Neutron Other: _____
 Name of organization running log(s): _____

Purpose of borehole (check one): Water Well Geotechnical/Geological Investigation _____ Ground Source Heat Pump _____
 Seismic Survey _____ Other (describe) _____
If drilling is not related to water well construction, skip the remainder of this block

Purpose of Well (check one): Home _____ Industrial _____ Public Supply _____ Irrigation Fish Culture _____ Other: _____

If a flowing well, method of flow regulation: Valve _____ Other (describe) _____

Static Water Level: 21 feet above or below (circle one) land surface Date measured: 4-14-10

Method of Measurement (circle one) steel tape electric tape air line other: _____

Well depth: 100' Well grouted to a depth of 10 feet Type of grout (circle one): Neat Cement Bentonite Mix

Casing length: 60 feet Casing diameter: 16" inches Type of casing: PVC

Screen length: 40 feet Screen diameter: 16 inches Type of screen: PVC

Screen slot size: 1.032 inches Setting depth: From 60 feet to 100 feet

Type of completion (circle all applicable): Gravel packed Underreamed Telescoped Open hole Natural Development
 Other (describe): _____

Top of lap pipe or reduction in casing: _____ feet. *If telescoped or more than one screen, describe on next page*

Form: OLWR-SWR-1A (04/08)

RECEIVED
 MAY 14 2010
 BY: OLWR

STATE WELL REPORT

5111

Part 2

Pump Installer's Completion Report
 Mississippi Department of Environmental Quality
 Office of Land and Water Resources
 P.O. Box 2309
 Jackson, MS 39225
 (601)961-5210
 (601)961-5228 (fax)

For Office Use Only:

Aquifer: _____
 Well #: J111
 Elevation: _____

County: Tunica
 Permit #: GW-44000
 Driller: Delta Drilling of Tunica
 Date completed: 4-10-10
Copy information from block on Part 1

This part of the report must be completed by a licensed water well contractor or a licensed pump installer. A copy of Part 1 of the report must be attached and both parts filed with the Department at the above address within 30 days of well completion.

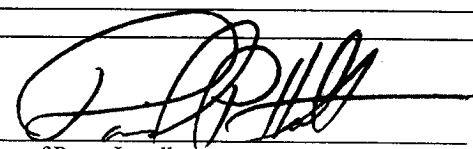
Well Owner Information	Well Location
Owner Name: <u>Patrick Johnson</u>	Latitude: <u>34°35'49.2"</u> Longitude: <u>90°25'57.4"</u>
Mailing Address: <u>P.O. Box 1052</u>	Method of Lat/Long (check one): Conventional Survey _____
<u>Tunica</u> <u>MS</u> <u>38676</u>	USGS quad _____, Hand-held GPS _____, Survey-grade GPS _____
City State Zip Code	_____ 1/4 _____ 1/4 Sec <u>2</u> T <u>6S</u> R <u>12W</u>
Telephone No. <u>(662) 357-5025</u>	Distance Direction Nearest Town
	<u>1</u> Miles <u>WSW</u> of <u>Clayton</u>

Pump Type Circle one	Power Type Circle one
Air Lift Jet Submersible	<u>Diesel Engine</u> Gasoline Engine Natural Gas
Bucket Piston <u>Turbine</u>	Electric Motor Hand Tractor PTO
Centrifugal Rotary Flowing Well	Windmill Other (specify): _____
Other (specify): _____	Horse Power Rating of Motor: <u>600</u>
Date Pump Installed: <u>4-15-10</u>	Setting Depth: <u>70</u> feet
Rated Pump Capacity: <u>2200</u> Gallons Per Minute	Number of Stages: <u>2</u>

Pump Test Data	Method of Measuring Water Level Circle one
Date Well Tested: _____	Air Line Electric Measuring Line <u>Steel Tape</u>
Static Water Level (A): <u>21</u> Feet Below Land Surface	Other (specify): _____
Pumping Water Level (B): _____ Feet Below Land Surface	For flowing well, measured shut in head: _____ feet
Drawdown [(B) - (A)]: _____ Feet Below Land Surface	Well yielded _____ GPM with a drawdown of _____ feet after _____ hours of pumping
Test Pumping Rate: _____ Gallons Per Minute	
Duration of Pump Test (minimum 4 hours): _____ hours	

I HEREBY CERTIFY that the above statements are true to the best of my knowledge.

DAVID P. HOLT 0-752P
 Print Name of Pump Installer and License No. (if applicable)


 Signature of Pump Installer

Form OLWR-SWR-1B (04/08)

RECEIVED

MAY 14 2010

BY: OLWR

JOB
10-071