

MISSISSIPPI DEPARTMENT OF NATURAL RESOURCES

Bureau of Land and Water Resources

Southport Mall

P.O. Box 10631

Jackson, Mississippi 39209

WATER WELL DRILLERS LOG

TUNICA
I 2000

8-10

date well completed

SPRINTA WELL IRRIGATION TUNICA

firm name

county well located

LANDOWNER: J. B. Boyd

description of formations encountered

from

to

Tunica ms

20 clay

0

20

7 INK SAND

20

50

COURSE SAND & GRAVEL

50

105

(mailing address)

WELL LOCATION:

sec. 1 T 6 N R 12 E


(distance) miles (direction) of (nearest town)

WELL PURPOSE:

(home, irrigation, municipal, industrial)

WELL COMPLETION DATA:

- (1) diameter (inches) 12"
- (2) total depth (feet) 105
- (3) static water level (feet) 17 below top of ground.

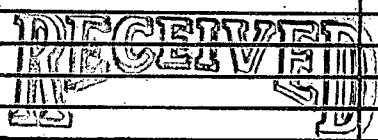

- (4) casing stall, 65 (material) (depth)
- 12" (size) if telescope see back.

- (5) screen 40 ft., 65' (length) (depth to top)
- 12 (size), stall (material)

- (6) pump (HP) 800 gpm (yield gpm)
- Diesel (type power)

- (7) electric log no (yes or no)


(organization running log)

- (8) how well bottom plugged Plata

DRILLERS REMARKS:

If well telescopes please sketch and show depths.

GROUND LEVEL

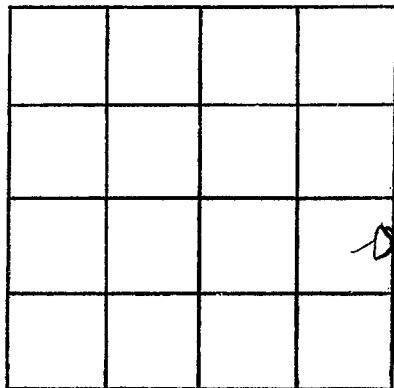

SECTION _____

Please indicate well location X.

ADDITIONAL INFORMATION

If more than one screen,
show locations of each on sketch.