

MISSISSIPPI DEPARTMENT OF NATURAL RESOURCES
Bureau of Land and Water Resources
 Southport Mall
 P.O. Box 10631
 Jackson, Mississippi 39209
WATER WELL DRILLERS LOG

TUNICA
JACO

8-12 1985 DRIFT WELL TUNICA TUNICA
 date well completed firm name county well located


LANDOWNER: J. D. Boyd
Tunica MS
 (mailing address)

description of formations encountered	from	to
0-200 clay	0	20
<u>fine sand</u>	20	55
<u>coarse sand & gravel</u>	55	110

WELL LOCATION:
 sec. 1 T. 6 N. R. 12 E.
 S W
 _____ miles _____ of _____
 (distance) (direction) (nearest town)

WELL PURPOSE:
 (home, irrigation, municipal, industrial)

- WELL COMPLETION DATA:
- (1) diameter (inches) 12"
 - (2) total depth (feet) 110
 - (3) static water level (feet) 18 below/above top of ground.
 - (4) casing stall 70
 (material) (depth)
12 if telescope see back.
 (size)
 - (5) screen 46 70
 (length) (depth to top)
12 stall
 (size) (material)
 - (6) pump 200
 (HP) (yield gpm)
DIESEL
 (type power)
 - (7) electric log NO
 (yes or no)
 - _____ (organization running log)
 - (8) how well bottom plugged Plugs

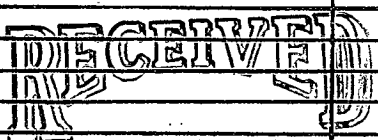


Department of Natural Resources
 Bureau of Land & Water Resources

DRILLERS REMARKS: _____

If well telescopes please sketch and show depths.

GROUND LEVEL

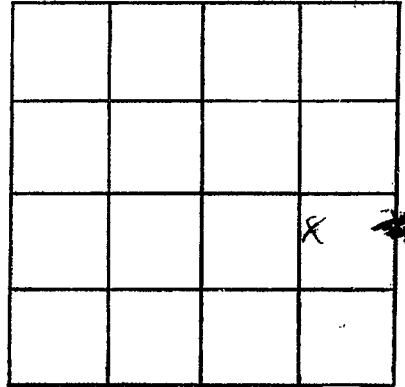

SECTION _____

Please indicate well location X.

ADDITIONAL INFORMATION

If more than one screen,
show locations of each on sketch.