

MISSISSIPPI DEPARTMENT OF NATURAL RESOURCES

Bureau of Land and Water Resources

Southport Mall

P.O. Box 10631

Jackson, Mississippi 39209

WATER WELL DRILLERS LOG

TUNICA
 2000


8-16 date well completed
 Delta Well & Drilling Tunica firm name
 county well located

LANDOWNER:	description of formations encountered	from	to
J.D. Boyd	clay	0	20
	fine sand	20	45
	coarse sand & gravel	45	103
(mailing address)			
WELL LOCATION:			
sec. 1 T. 6 N. R. 12 E. S. W.			
miles (distance) of (direction) of (nearest town)			
WELL PURPOSE:			
(home, irrigation, municipal, industrial)			
WELL COMPLETION DATA:			
(1) diameter (inches) 12			
(2) total depth (feet) 103			
(3) static water level (feet) 18 below top of ground.			
(4) casing steel 63 (material) (depth)			
12" (size) if telescope see back.			
(5) screen 40 63 (length) (depth to top)			
12" (size) steel (material)			
(6) pump 800 (HP) (yield gpm)			
Diesel (type power)			
(7) electric log no (yes or no)			
(organization running log)			
(8) how well bottom plugged Plaster			
DRILLERS REMARKS:			



If well telescopes please sketch and show depths.

GROUND LEVEL

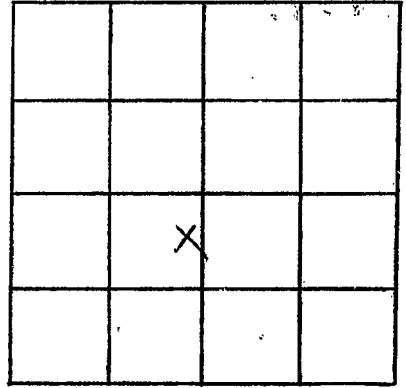

SECTION _____

Please indicate well location X.

ADDITIONAL INFORMATION

If more than one screen, show locations of each on sketch.