

MISSISSIPPI DEPARTMENT OF NATURAL RESOURCES

Bureau of Land and Water Resources

Southport Mall

P.O. Box 10631

Jackson, Mississippi 39209

WATER WELL DRILLERS LOG

TUNICA
J2003

8-17 1980 *Wells Incorporated Tunica*  
 date well completed firm name county well located

LANDOWNER:	description of formations encountered	from	to
<i>J D Boyd Tunica ms</i>	<i>clay fine sand</i>	<i>0</i>	<i>20</i>
(mailing address)		<i>20</i>	<i>55</i>
		<i>55</i>	<i>110</i>
WELL LOCATION:			
sec. <i>1</i> T. <i>6</i> N. R. <i>12</i> E. S W			
(distance) miles (direction) of (nearest town)			
WELL PURPOSE: (home, irrigation, municipal, industrial)			
WELL COMPLETION DATA:			
(1) diameter (inches) <i>12"</i>			
(2) total depth (feet) <i>110</i>			
(3) static water level (feet) <i>17</i> below top of ground.			
(4) casing <i>Steel 70</i> (material) (depth)			
<i>12"</i> (size) if telescope see back.			
(5) screen <i>40ft. 70</i> (length) (depth to top)			
<i>12</i> <i>Steel</i> (size) (material)			
(6) pump <i>800</i> (HP) (yield gpm)			
<i>Diesel</i> (type power)			
(7) electric log <i>no</i> (yes or no)			
(organization running log)			
(8) how well bottom plugged <i>plate</i>			


RECEIVED  
 APR 21 1986

DEPARTMENT of Natural RESOURCES  
 Bureau of Land & Water RESOURCES

DRILLERS REMARKS:

If well telescopes please sketch and show depths.

GROUND LEVEL

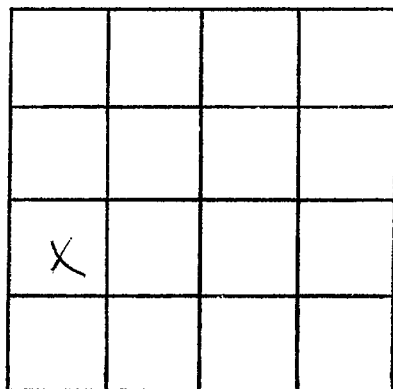

SECTION \_\_\_\_\_

Please indicate well location X.

ADDITIONAL INFORMATION

If more than one screen,  
show locations of each on sketch.