

TUNICA  
K2  
7-6-72

MISSISSIPPI  
BOARD OF WATER COMMISSIONERS  
416 North State Street  
Jackson, Mississippi 39201

**CODED**

WATER WELL DRILLERS LOG

7-6-72 19 J.H. Abel + Son TUNICA  
date well completed firm name county well located


LANDOWNER:	description of formations encountered	from	to
RYDER WEST DUNDEE MISS. (mailing address)	CLAY FINE SAND COARSE SAND	0 20 28	20 28 46
<p>WELL LOCATION:</p> <p>sec <u>27</u> T-<u>6</u> R-<u>11</u> E  <small>(N) (W)</small>          GIN IN CITY OF <u>DUNDEE</u>  <small>(distance) (direction) (nearest town)</small></p>			
<p>WELL PURPOSE: <u>GIN</u>  <small>(home, irrigation, municipal, industrial)</small></p>			
<p>WELL COMPLETION DATA:</p>			
<p>(1) diameter (inches) <u>1 1/4</u></p>			
<p>(2) total depth (feet) <u>46</u></p>			
<p>(3) static water level (feet) <u>17</u> <small>(below)</small> above top of ground.</p>			
<p>(4) casing <u>Galv.</u> <u>42</u>  <small>(material) (depth)</small>  <u>1 1/4"</u> if telescope see back.  <small>(size)</small></p>			
<p>(5) screen <u>48"</u> <u>42</u>  <small>(length) (depth to top)</small>  <u>1 1/4</u> <u>BRASS</u>  <small>(size) (material)</small></p>			
<p>(6) pump _____ (HP) _____ (yield gpm)  <small>(type power)</small></p>			
<p>(7) electric log _____  <small>(yes or no)</small>          _____  <small>(organization running log)</small></p>			
<p>(8) how well bottom plugged <u>DRIVE POINT</u></p>			
<p>DRILLERS REMARKS:  <u>CUSTOMER TO FURNISH</u>  <u>+ INSTALL OWN</u>  <u>PUMP</u></p>			

**CODED**

MISSISSIPPI  
BOARD OF WATER COMMISSIONERS  
JUL 10 1972

If well telescopes please sketch and show depths.

GROUND LEVEL

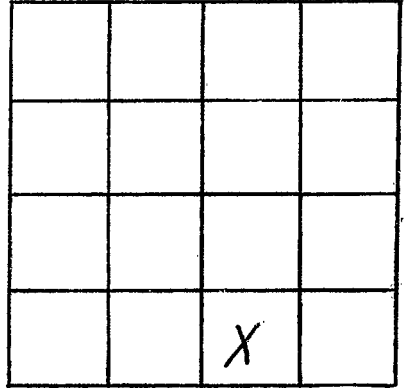

SECTION 27

Please indicate well location X.

ADDITIONAL INFORMATION

If more than one screen,  
show locations of each on sketch.