

TUNICA
K3
7-21-72

MISSISSIPPI
 BOARD OF WATER COMMISSIONERS
 416 North State Street
 Jackson, Mississippi 39201

CODED

WATER WELL DRILLERS LOG


7-21- 1972 J.H. Abel & Son TUNICA
 date well completed firm name county well located

| LANDOWNER: | description of formations encountered | from | to |
|---|---------------------------------------|-----------|-----------|
| <u>Ryder West</u> | | | |
| <u>Dundee MISS</u> (mailing address) | <u>CLAY</u> | <u>0</u> | <u>10</u> |
| WELL LOCATION: sec <u>34</u> T <u>6</u> N R <u>11</u> E <u>1/4</u> miles <u>S</u> of <u>Dundee</u> (distance) (direction) (nearest town) | <u>FINE wet SAND</u> | <u>10</u> | <u>15</u> |
| WELL PURPOSE: <u>CATTLE</u> (home, irrigation, municipal, industrial) | <u>CLAY</u> | <u>15</u> | <u>25</u> |
| WELL COMPLETION DATA: | <u>COARSE SAND</u> | <u>25</u> | <u>46</u> |
| (1) diameter (inches) <u>1 1/4</u> | CODED | | |
| (2) total depth (feet) <u>46</u> | | | |
| (3) static water level (feet) <u>17</u> below top of ground. | | | |
| (4) casing <u>GALV</u> , <u>4.2</u> (material) (depth) | | | |
| _____ If telescope see back. (size) | | | |
| (5) screen <u>48"</u> , <u>42"</u> (length) (depth to top) | | | |
| <u>1/4</u> , <u>BRASS</u> (size) (material) | | | |
| (6) pump <u>CUSTOMER TO</u> (HP) (yield gpm) | | | |
| <u>FURNISH OWN PUMP</u> (type power) | | | |
| (7) electric log _____ (yes or no) | | | |
| _____ (organization running log) | | | |
| (8) how well bottom plugged _____ <u>DRIVE POINT</u> | | | |
| DRILLERS REMARKS: | | | |

MISS. SD. OF
 WATER BOARD

If well telescopes please sketch and show depths.

GROUND LEVEL

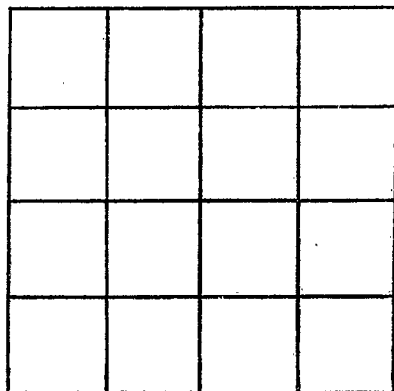

SECTION _____

Please indicate well location X.

ADDITIONAL INFORMATION

If more than one screen,
show locations of each on sketch.