

Tunica
R4
7-11-69

MISSISSIPPI
 BOARD OF WATER COMMISSIONERS
 416 North State Street
 Jackson, Mississippi 39201

9/11/69
 JM
 12707

WATER WELL DRILLERS LOG

CODED

#3

July 11, 1969 Layne-Central Company
 date well completed firm name

Tunica
 county well located

LANDOWNER: Oaklawn Plantation
 Inc.

At Dubbs, Mississippi

description of fomations
 encountered

from to

Clay

0

45

Coarse sand

45

70

Coarse sand and gravel

70

102

Dundee, Mississippi
 (mailing address)

WELL LOCATION:

sec. 16 T. 6 N. R. 11 E.
 S W
 (distance) miles 1 1/2 of Dubbs
 (direction) (nearest town)

WELL PURPOSE: irrigation
 (home, irrigation, municipal, industrial)

WELL COMPLETION DATA:

(1) diameter (inches) 12"

(2) total depth (feet) 102'

(3) static water level (feet) 15' 7" ~~below~~ above
 top of ground.

(4) casing steel, 62'
 (material) (depth)
12" if telescope see back.
 (size)

(5) screen 40', 102'
 (length) (depth to top)
12", Armco
 (size) (material)

(6) pump 40, 1500
 (HP) (yield gpm)
engine
 (type power)

(7) electric log no
 (yes or no)
 (organization running log)

(8) how well bottom plugged plate

CODED


SEP 19 1969

DRILLERS REMARKS:

MISS. BD. OF
 WATER COM.

If well telescopes please sketch and show depths.

GROUND LEVEL

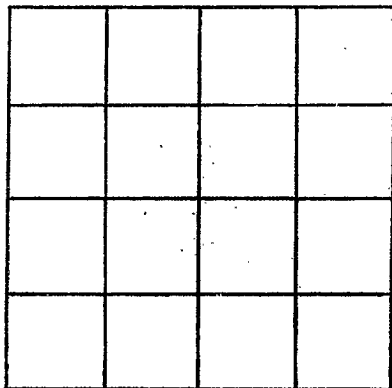

SECTION 16

Please indicate well location X.

ADDITIONAL INFORMATION

If more than one screen,
show locations of each on sketch.