

Tunica
 K5
 7-12-69

MISSISSIPPI
 BOARD OF WATER COMMISSIONERS
 416 North State Street
 Jackson, Mississippi 39201

9/11/69
 Jma
 12707

WATER WELL DRILLERS LOG

CODED

#4

July 12, 1969 Layne-Central Company Tunica
 date well completed firm name county well located

LANDOWNER: Oaklawn Plantation
 At Dubbs, Mississippi
 Dundee, Mississippi
 (mailing address)

Description of formations encountered	from	to
Clay	0	42
Gravel	42	70
Coarse sand	70	96
Fine black sand.	96	99
Set at		96

WELL LOCATION:
 sec. 16 T. 6 N R. 11 E
 S W
 miles 1.2 of Dubbs
 (distance) (direction) (nearest town)

CODED

WELL PURPOSE: irrigation
 (home, irrigation, municipal, industrial)

- WELL COMPLETION DATA:
- (1) diameter (inches) 12
 - (2) total depth (feet) 96
 - (3) static water level (feet) 15' 7" ~~above~~ above top of ground.
 - (4) casing steel, 56' (material) (depth), 12" (size) if telescope see back.
 - (5) screen 40', 96' (length) (depth to top), 12" (size), Armco (material)
 - (6) pump 40 (HP), 1500 (yield gpm), engine (type power)
 - (7) electric log no (yes or no)
 (organization running log)
 - (8) how well bottom plugged plate

CODED


SEP 16 1969

DRILLERS REMARKS:

MISSISSIPPI
 BOARD OF
 WATER COMMISSIONERS

If well telescopes please sketch and show depths.

GROUND LEVEL

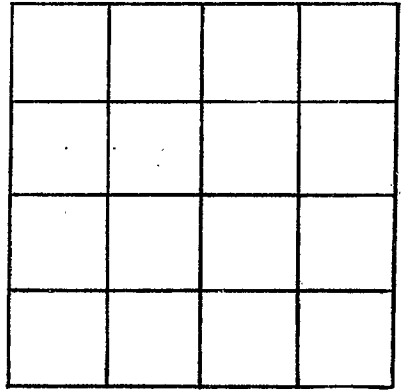

SECTION 16

Please indicate well location X.

ADDITIONAL INFORMATION

If more than one screen, show locations of each on sketch.