

Tunica  
K 6  
4-17-70

MISSISSIPPI  
BOARD OF WATER COMMISSIONERS  
416 North State Street  
Jackson, Mississippi 39201

**CODED**

WATER WELL DRILLERS LOG

4-17-1970 date well completed  
J.H. ARBELLSON, Inc. firm name  
TUNICA county well located

LANDOWNER:  
B.R. SMITH FARM  
DwD E E MISS  
(mailing address)

description of formations encountered	from	to
CLAY	1'	20'
FINE SAND	20'	40'
MED SAND	40'	50'
COURSE SAND	50'	69'

WELL LOCATION:  
sec. 8 T 6 S R 11 E  
1 miles NE of DuBOS  
(distance) (direction) (nearest town)

WELL PURPOSE: BALL PREMERITON  
(home, irrigation, municipal, industrial)

WELL COMPLETION DATA:

(1) diameter (inches) 2"

(2) total depth (feet) 69'

(3) static water level (feet) 16' below top of ground.

(4) casing 2" GALV. (material) 63' (depth)  
if telescope see back.  
(size)

(5) screen 6' (length) 63' (depth to top)  
2" ROSS GALV. POINT (size) (material)

(6) pump 1/2 HP (HP) 35 (yield gpm)  
ELECTRIC (type power)

(7) electric log NO (yes or no)  
(organization running log)

(8) how well bottom plugged STEEL POINT

**CODED**


APR 30 1970

MISS. BD. OF  
WATER COMM.

DRILLERS REMARKS: WELL USED TO FILL PREMERITON AND ROSS FARM

If well telescopes please  
sketch and show depths.

GROUND LEVEL

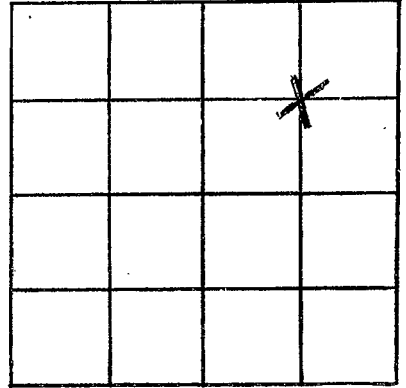

SECTION \_\_\_\_\_

Please indicate well location X.

ADDITIONAL INFORMATION

If more than one screen,  
show locations of each on sketch.