

TUNICA MISSISSIPPI BOARD OF WATER COMMISSIONERS

K 7

7-28-65

WATER WELL DRILLERS LOG

CODED

Date: July 28, 1965, Driller: Shelly Neyma County Prentiss
 1759, 60 2401 (Name)

(1) Owner of Land:	Description & Color of Materials Sand, Clay, Red Clay, Shell, etc.	Thick- ness Feet	Depth Feet
(Name) <u>Mr. France</u> <u>Dundee Miss</u> (Address) <u>14 6 11</u>	<u>Blue Clay</u>	<u>16</u>	
(2) Location: <u>1/4, 1/4, Sec. 7, 8 T. 6 R. 10,</u> <u>2</u> miles <u>S</u> of <u>Dubbs</u> (distance) (direction) (Nearest Town) <u>Sand</u>			<u>74</u>
(3) Topography: <input checked="" type="checkbox"/> (Hilly) <input checked="" type="checkbox"/> (Flat) <input type="checkbox"/> (Level)			
(4) Purpose of Well: <input checked="" type="checkbox"/> (Domestic Irrigation) <input type="checkbox"/> (Municipal, Industrial, Other)			

Information upon completion of well:

(1) Diameter 2 inches.

(2) Total Depth 90 feet.

(3) Water Level 16 feet below top of ground.

(4) Cased to _____, Size _____


(5) Screen: Size 6, Length 6 ft St. St.

(6) Were any formations sealed against pollution?
 _____ yes, no.

If YES depth of formation _____

Why _____

Drillers Remarks: _____

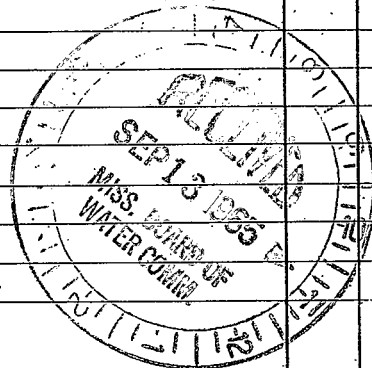

(Use Back Side)

Well No.

Handwritten text, likely bleed-through from the reverse side of the page. The text is extremely faint and illegible due to the high contrast of the scan. It appears to be a list or a series of entries, possibly containing names and dates, but the characters are too light to be accurately transcribed.